DIRECTION	MILEPOINT	LOCATION CODE (SHEET 4)	SIGN CODE	WIDTH (IN)	HEIGHT (IN)	SHEETING REMARKS	SIGN LEGEND	NEW SIGNS "A"	NEW SIGNS "B"	EXISTING SIGNS RETAIN	EXISTING SIGNS SALVAGE FROM	EXISTING SIGNS SALVAGE TO	EXISTING SIGNS REMOVE	EXIST POST RETAIN	EXIST POST REMOVE	NUMBER OF NEW POSTS	SQUARE STEEL (IN) 1.75 / 2.00 / 2.50 (LB / FT) 1.88 / 2.42 / 3.35	TUBULAR STEEL Ø (IN) FOUNDATION	TUBULAR STEEL Ø (IN) 3.00 / 3.50 / 4.00 / 5.00 (LB / FT) 7.60 / 9.00 / 10.80 / 14.60	SIGN FRAME REQUIRED	REMARKS	SIGN DETAIL LOCATION SHSM	SIGN DETAIL LOCATION SIGN DETAIL SHEET #	SIGN DETAIL LOCATION STANDARD SHEET #
NB HINESBURG TH-9							FY-FLUORESCENT YELLOW FYG-FLUORESCENT YELLOW GREEN														"SHSM"-STANDARD HIGHWAY SIGNS AND MARKINGS BOOK			
NB	1.159	D	R1-1				STOP						1		X						5-3-18			
		AB	D3-1				HAYDEN HILL RD W						1											
		D	R1-1	30	30			6.25								1	14.00 X					X	
NB	1.159	AB	D3-1	68	12			5.67								2	10.75 X ~~12.00~~						9	
NB	1.200	A	R2-1	24	30			5.00								1	13.50 X				INSTALL 50 FT ± NORTH OF AND ACROSS FROM UTILITY POLE V/E/COOP/33/19/3x AT MP 1.190	X		
NB	2.200	A	W2-1	36	36			9.00								2	16.25 X ~~16.75~~					X		
		A	W16-8a	48	18			6.00															9	
NB	2.238	A	VD1-1A	72	12		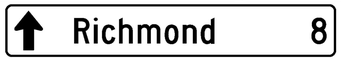	6.00								2	11.75 X ~~12.60~~						9	T-93
NB	2.268	AB	D3-1				TEXAS HILL RD			1				X										
		CD	D3-1				NORTH RD			1														
NB	2.268	C	R2-5A				REDUCED SPEED AHEAD						1		X						REMOVE SIGN FROM TEXAS HILL RD			
NB	2.280	D	R1-1				STOP						1		X						5-2-18			
		D	R1-1	30	30			6.25								1	13.50 X					X		
NB	2.293	A	W3-2				YIELD AHEAD						1		X									
		A	W3-2	30	30			6.25								1	13.25 X					X		
SIGN SUMMARY SHEET							SHEET TOTALS	50.42	0.00	2	0	0	5	0	0	10	134.25 ~~150.0~~	0	0.0	0.0	0.0	0.0			
								SF	SF	EA	EA	EA	EA	EA	EA	EA	FT	EA	LB	LB	LB	LB			
VERMONT AGENCY OF TRANSPORTATION							TOWN DIRECTIONAL TOTALS	93.1	0.0	4	0	0	16	0	0	16	240.0	0	0.0						

PROJECT NAME: **STATEWIDE-NORTH REGION**
PROJECT NUMBER: **STP HRRR(22)**
FILE NAME: **z14k100tsshinesbura TH9 NE** PLOT DATE: **5/5/2017**
PROJECT MANAGER: **K. RUTTER** DRAWN BY: **R. SHEDD**
DESIGNED BY: **R. SHEDD** CHECKED **S. GOODWIN**
HINESBURG TH-9 NORTHBOUND 3 SHEET **113** OF **255**