DIRECTION	MILEPOINT	LOCATION CODE (SHEET 4)	SIGN CODE	WIDTH (IN)	HEIGHT (IN)	SHEETING REMARKS	SIGN LEGEND	NEW SIGNS "A"	NEW SIGNS "B"	EXISTING SIGNS RETAIN	EXISTING SIGNS SALVAGE FROM	EXISTING SIGNS SALVAGE TO	EXISTING SIGNS REMOVE	EXIST POST RETAIN	EXIST POST REMOVE	NUMBER OF NEW POSTS	SQUARE STEEL (IN) 1.75 / 2.00 / 2.50 (LB / FT) 1.88 / 2.42 / 3.35	TUBULAR STEEL Ø (IN) FOUNDATION	TUBULAR STEEL Ø (IN) 3.00 / 3.50 / 4.00 / 5.00 (LB / FT) 7.60 / 9.00 / 10.80 / 14.60	SIGN FRAME REQUIRED	REMARKS	SIGN DETAIL LOCATION SHSM	SIGN DETAIL LOCATION SIGN DETAIL SHEET #	SIGN DETAIL LOCATION STANDARD SHEET #
NB HYDE PARK TH-1							FY-FLUORESCENT YELLOW FYG-FLUORESCENT YELLOW GREEN														"SHSM"-STANDARD HIGHWAY SIGNS AND MARKINGS BOOK			
NB	0.000	CD	D3-1				CENTERVILLE RD						1		X						5-10-18			
		CD	D3-1	56	12		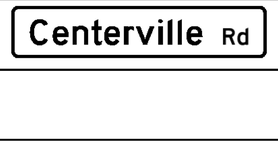	4.67								2	10.00 X ~~10.25~~					10	
NB	0.008	A	R2-1	24	30			5.00								1	15.75 X				INSTALL 40 FT ± UP CENTERVILLE RD FROM E MAIN ST	X		
NB	0.090	A	R1-1				STOP			1				X										
NB	0.100	CD	D3-1				CENTERVILLE RD						1		X									
		CD	D3-1	56	12			4.67								2	11.50 X ~~12.00~~					10	
NB	0.100	A	VR-017	24	30			5.00								1	15.75 X				~~SLIP BASE REQUIRED~~ SEE SHEET 9			T-70
		A	R2-1	24	30			5.00														X		
NB	0.116	A	VR-017				LLL 24,000 LBS						1		X									
NB	0.159	A	R2-1				SPEED LIMIT 25						1		X									
		A	W11-8	30	30			6.25								1	14.25 X					X		
NB	0.646	B	W1-6				LARGE ARROW RIGHT						1		X									
NB	0.650	B	W1-6	48	24			8.00								2	13.00 X ~~12.25~~				5-8-18 INSTALL 20 FT ± NORTH OF EXISTING SIGN AT MP 0.646	X		
NB	0.665	C	R2-1				SPEED LIMIT 25						1		X									
		C	R2-1	24	30			5.00								1	13.25 X				INSTALL NEW SIGN CLOSER TO CENTERVILLE RD, IN LINE WITH STOP SIGN	X		
SIGN SUMMARY SHEET							SHEET TOTALS	43.58	0.00	1	0	0	6	0	0	10	~~150.0~~ 128.00	0	0.0	0.0	0.0	0.0			
								SF	SF	EA	EA	EA	EA	EA	EA	EA	FT	EA	LB	LB	LB	LB			
VERMONT AGENCY OF TRANSPORTATION							TOWN DIRECTIONAL TOTALS	153.2	0.0	10	0	0	20	0	0	31	465.0	0	0.0						

PROJECT NAME: **STATEWIDE-NORTH REGION**
PROJECT NUMBER: **STP HRRR(22)**
FILE NAME: **z14k100tsshydepark TH1 NB.** PLOT DATE: **5/5/2017**
PROJECT MANAGER: **K. RUTTER** DRAWN BY: **R. SHEDD**
DESIGNED BY: **R. SHEDD** CHECKED **S. GOODWIN**
HYDE PARK TH-1 NORTHBOUND 1 SHEET **117** OF **255**