DIRECTION	MILEPOINT	LOCATION CODE (SHEET 4)	SIGN CODE	WIDTH (IN)	HEIGHT (IN)	SHEETING REMARKS	SIGN LEGEND	NEW SIGNS "A"	NEW SIGNS "B"	EXISTING SIGNS RETAIN	EXISTING SIGNS SALVAGE FROM	EXISTING SIGNS SALVAGE TO	EXISTING SIGNS REMOVE	EXIST POST RETAIN	EXIST POST REMOVE	NUMBER OF NEW POSTS	SQUARE STEEL (IN) 1.75 (LB / FT) 1.88	SQUARE STEEL (IN) 2.00 (LB / FT) 2.42	SQUARE STEEL (IN) 2.50 (LB / FT) 3.35	FOUNDATION	TUBULAR STEEL Ø (IN) 3.00 (LB / FT) 7.60	TUBULAR STEEL Ø (IN) 3.50 (LB / FT) 9.00	TUBULAR STEEL Ø (IN) 4.00 (LB / FT) 10.80	TUBULAR STEEL Ø (IN) 5.00 (LB / FT) 14.60	SIGN FRAME REQUIRED	REMARKS	SIGN DETAIL LOCATION SHSM	SIGN DETAIL LOCATION SIGN DETAIL SHEET #	SIGN DETAIL LOCATION STANDARD SHEET #
NB HYDE PARK TH-3							FY-FLUORESCENT YELLOW FYG-FLUORESCENT YELLOW GREEN																			"SHSM"-STANDARD HIGHWAY SIGNS AND MARKINGS BOOK 5-15-18			
NB	4.318						REMOVE EMPTY POST								X											PAID FOR AS ITEM 676.12, REMOVAL OF EXISTING DELINEATOR, SEE SHEET 8			
NB	4.387	A	W3-1	30	30		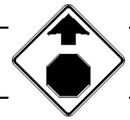	6.25								1		13.50 X								INSTALL 10 FT ± SOUTH OF UTILITY POLE 2/2 AT MP 4.389	X		
NB	4.442	A	R1-1				STOP						1		X													
		A	R1-1	30	30			6.25								1		13.25 X									X		
NB	4.445	CD	D3-1				FERRY ST						1		X													
		CD	D3-1	36	12			3.00								1		11.00 X										11	
																								1 DEL. REM.				
SIGN SUMMARY SHEET							SHEET TOTALS	15.50	0.00	0	0	0	2	0	0	3		37.75 ~~45.0~~		0	0.0	0.0	0.0	0.0				
								SF	SF	EA	EA	EA	EA	EA	EA	EA		FT		EA	LB	LB	LB	LB				
VERMONT AGENCY OF TRANSPORTATION							TOWN DIRECTIONAL TOTALS	187.9	0.0	2	2	2	24	0	0	40		600.0		0	0.0							

PROJECT NAME: STATEWIDE-NORTH REGION
PROJECT NUMBER: STP HRRR(22)
FILE NAME: z14k100tsshydepark TH3 NB. PLOT DATE: 5/5/2017
PROJECT MANAGER: K. RUTTER DRAWN BY: R. SHEDD
DESIGNED BY: R. SHEDD CHECKED S. GOODWIN
HYDE PARK TH-3 NORTHBOUND 5 SHEET 129 OF 255