DIRECTION	MILEPOINT	LOCATION CODE (SHEET 4)	SIGN CODE	WIDTH (IN)	HEIGHT (IN)	SHEETING REMARKS	SIGN LEGEND	NEW SIGNS "A"	NEW SIGNS "B"	EXISTING SIGNS RETAIN	EXISTING SIGNS SALVAGE FROM	EXISTING SIGNS SALVAGE TO	EXISTING SIGNS REMOVE	EXIST POST RETAIN	EXIST POST REMOVE	NUMBER OF NEW POSTS	SQUARE STEEL (IN) 1.75 (LB / FT) 1.88	SQUARE STEEL (IN) 2.00 (LB / FT) 2.42	SQUARE STEEL (IN) 2.50 (LB / FT) 3.35	TUBULAR STEEL Ø (IN) FOUNDATION	TUBULAR STEEL Ø (IN) 3.00 (LB / FT) 7.60	TUBULAR STEEL Ø (IN) 3.50 (LB / FT) 9.00	TUBULAR STEEL Ø (IN) 4.00 (LB / FT) 10.80	TUBULAR STEEL Ø (IN) 5.00 (LB / FT) 14.60	SIGN FRAME REQUIRED	REMARKS	SIGN DETAIL LOCATION SHSM	SIGN DETAIL LOCATION SIGN DETAIL SHEET #	SIGN DETAIL LOCATION STANDARD SHEET #
SB MORRISTOWN TH-6							FY-FLUORESCENT YELLOW FYG-FLUORESCENT YELLOW GREEN																			"SHSM"-STANDARD HIGHWAY SIGNS AND MARKINGS BOOK			
SB	6.003	E	OM1-1				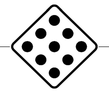 OBJECT MARKER																			5-19-18			
		E	OM1-1	18	18			2.25								1		10.00 X								INSTALL IN SAME LOCATION IN ISLAND FACING RANDOLPH RD	X		
SB	6.003	E	R1-1				STOP						1		X														
		E	R1-1	30	30			6.25								1		13.25 X								INSTALL IN SAME LOCATION IN ISLAND FACING RANDOLPH RD	X		
SB	6.003	E					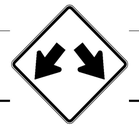 ROAD SPLITS ARROWS						1		X														
		E	W12-1	30	30			6.25								1		14.00 X								INSTALL IN SAME LOCATION IN ISLAND FACING RANDOLPH RD	X		
SB	5.995	EF	D3-1				MAIN ST						1		X														
		GH	D3-1				RANDOLPH RD						1																
		EF	D3-1	36	12		Main St	3.00								2		16.50 X 16.75								INSTALL 90 DEGREES TO RANDOLPH RD		13	
		GH	D3-1	52	12		Randolph Rd	4.33																				13	
SB	5.988	F	R2-1				SPEED LIMIT 25						1		X														
		F	R2-1	24	30			5.00								1		14.00 X									X		
SB	5.965	F					(BICYCLE) SINGLE FILE ONLY						1		X														
		F	W11-1	30	30			6.25								1		17.00 X									X		
		F		18	24		SINGLE FILE ONLY	3.00																				25	
SIGN SUMMARY SHEET							SHEET TOTALS	36.33	0.00	0	0	0	6	0	0	7		101.50 ~~105.0~~		0	0.0	0.0	0.0	0.0					
								SF	SF	EA	EA	EA	EA	EA	EA	EA		FT		EA	LB	LB	LB	LB					
VERMONT AGENCY OF TRANSPORTATION							TOWN DIRECTIONAL TOTALS	264.2	0.0	1	0	0	43	0	0	51		765.0		0	0.0								

PROJECT NAME: **STATEWIDE-NORTH REGION**
PROJECT NUMBER: **STP HRRR(22)**
FILE NAME: **z14k100tssmorristown TH6 S**
PROJECT MANAGER: **K. RUTTER**
DESIGNED BY: **R. SHEDD**
PLOT DATE: **5/5/2017**
DRAWN BY: **R. SHEDD**
CHECKED **S. GOODWIN**
MORRISTOWN TH-6 SOUTHBOUND 1
SHEET **150** OF **255**