DIRECTION	MILEPOINT	LOCATION CODE (SHEET 4)	SIGN CODE	WIDTH (IN)	HEIGHT (IN)	SHEETING REMARKS	SIGN LEGEND	NEW SIGNS "A"	NEW SIGNS "B"	EXISTING SIGNS RETAIN	EXISTING SIGNS SALVAGE FROM	EXISTING SIGNS SALVAGE TO	EXISTING SIGNS REMOVE	EXIST POST RETAIN	EXIST POST REMOVE	NUMBER OF NEW POSTS	SQUARE STEEL (IN) 1.75 (LB / FT) 1.88	SQUARE STEEL (IN) 2.00 (LB / FT) 2.42	SQUARE STEEL (IN) 2.50 (LB / FT) 3.35	TUBULAR STEEL Ø (IN) FOUNDATION	TUBULAR STEEL Ø (IN) 3.00 (LB / FT) 7.60	TUBULAR STEEL Ø (IN) 3.50 (LB / FT) 9.00	TUBULAR STEEL Ø (IN) 4.00 (LB / FT) 10.80	TUBULAR STEEL Ø (IN) 5.00 (LB / FT) 14.60	SIGN FRAME REQUIRED	REMARKS	SIGN DETAIL LOCATION SHSM	SIGN DETAIL LOCATION SIGN DETAIL SHEET #	SIGN DETAIL LOCATION STANDARD SHEET #
SB MORRISTOWN TH-6							FY-FLUORESCENT YELLOW FYG-FLUORESCENT YELLOW GREEN																			"SHSM"-STANDARD HIGHWAY SIGNS AND MARKINGS BOOK			
SB	5.856	F	R2-1				SPEED LIMIT 25						1		X											5-21-18			
		F	R2-1	24	30			5.00								1		13.00 X									X		
SB	5.833	F	W1-1L	30	30			6.25								1		17.50 X								INSTALL 120 FT ± SOUTH OF EXISTING SIGN AT MP 8.856	X		
SB	5.766	F	R2-1				SPEED LIMIT 35						1		X														
		F	R2-1	24	30			5.00								1		13.25 X								SL SIGN IN SIGHT DISTANCE	X		
SB	5.749	EF	D3-1				COTTAGE ST						1		X														
SB	5.749	G	VR-017				LLL 24,000 LBS						1		X														
		G					~~SL SIGN~~									~~1~~		~~X~~								UNNECESSARY ~~REPLACE WITH I SL SIGN.~~			
SB	5.741	H	R1-1				STOP						1		X														
		EF	D3-1	42	12		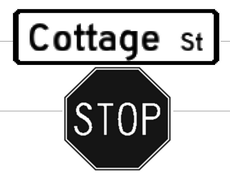	3.50								1		12.75 X								MOUNT COTTAGE ST PERP ON TOP OF STOP SIGN		13	
		H	R1-1	30	30			6.25																			X		
SB	5.502	F	R2-1				SPEED LIMIT 35						1		X														
		F	R2-1	24	30			5.00								1		14.25 X									X		
SB	5.310	F	R2-1				SPEED LIMIT 35						1		X														
SB	5.027	F	R2-1	24	30			5.00								1		14.00 X								INSTALL 150 FT ± NORTH OF UTILITY POLE 28 AT MP 4.999	X		
							SHEET TOTALS	36.00	0.00	0	0	0	7	0	0	7		84.75 ~~105.0~~		0	0.0	0.0	0.0	0.0				
								SF	SF	EA	EA	EA	EA	EA	EA	EA		FT		EA	LB	LB	LB	LB				
							TOWN DIRECTIONAL TOTALS	264.2	0.0	1	0	0	43	0	0	51		765.0		0	0.0							

SIGN SUMMARY SHEET

VERMONT AGENCY OF TRANSPORTATION

PROJECT NAME: **STATEWIDE-NORTH REGION**
PROJECT NUMBER: **STP HRRR(22)**

FILE NAME: **z14k100tssmorristown TH6 S** PLOT DATE: **5/5/2017**
PROJECT MANAGER: **K. RUTTER** DRAWN BY: **R. SHEDD**
DESIGNED BY: **R. SHEDD** CHECKED **S. GOODWIN**
MORRISTOWN TH-6 SOUTHBOUND 2 SHEET **151** OF **255**