DIRECTION	MILEPOINT	LOCATION CODE (SHEET 4)	SIGN CODE	WIDTH (IN)	HEIGHT (IN)	SHEETING REMARKS	SIGN LEGEND	NEW SIGNS "A"	NEW SIGNS "B"	EXISTING SIGNS RETAIN	EXISTING SIGNS SALVAGE FROM	EXISTING SIGNS SALVAGE TO	EXISTING SIGNS REMOVE	EXIST POST RETAIN	EXIST POST REMOVE	NUMBER OF NEW POSTS	SQUARE STEEL (IN) 1.75 (LB / FT) 1.88	SQUARE STEEL (IN) 2.00 (LB / FT) 2.42	SQUARE STEEL (IN) 2.50 (LB / FT) 3.35	TUBULAR STEEL Ø (IN) FOUNDATION	TUBULAR STEEL Ø (IN) 3.00 (LB / FT) 7.60	TUBULAR STEEL Ø (IN) 3.50 (LB / FT) 9.00	TUBULAR STEEL Ø (IN) 4.00 (LB / FT) 10.80	TUBULAR STEEL Ø (IN) 5.00 (LB / FT) 14.60	SIGN FRAME REQUIRED	REMARKS	SIGN DETAIL LOCATION SHSM	SIGN DETAIL LOCATION SIGN DETAIL SHEET #	SIGN DETAIL LOCATION STANDARD SHEET #
EB ROXBURY TH-1							FY-FLUORESCENT YELLOW FYG-FLUORESCENT YELLOW GREEN																			"SHSM"-STANDARD HIGHWAY SIGNS AND MARKINGS BOOK			
EB	2.314	A	W1-5R				WINDING ROAD WARNING						1		X											5-25-18			
		A	W1-5R	30	30			6.25								1		13.00 X									X		
EB	2.363	A	R2-1				SPEED LIMIT 30						1		X														
		A	R2-1	30	36			7.50								1		14.25 X									X		
EB	2.588	C	D3-1				WEBSTER RD						1		X														
		C	VR-017				LLL 16,000 LBS						1																
		C	D3-1	42	12		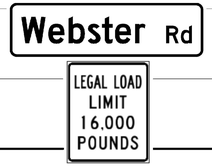	3.50								1		11.50 X									18		
		C	VR-017	24	30			5.00								1		11.00 X											T-70
EB	2.597	D	R1-1				STOP						1		X														
		D	R1-1	30	30			6.25								1		12.50 X									X		
EB	2.747	A	R2-1				SPEED LIMIT 30						1		X														
EB	2.767	A	R2-1	24	30			5.00								1		13.00 X									INSTALL 105 FT ± EAST OF EXISTING SIGN AT MP 2.747	X		
EB	2.855	A	W3-1				STOP AHEAD						1		X											5-29-18			
		A	W3-1	30	30			6.25								1		14.75 X										X		
SIGN SUMMARY SHEET							SHEET TOTALS	39.75	0.00	0	0	0	7	0	0	7		90.00 ~~105.0~~		0	0.0	0.0	0.0	0.0					
								SF	SF	EA	EA	EA	EA	EA	EA	EA		FT		EA	LB	LB	LB	LB					
VERMONT AGENCY OF TRANSPORTATION							TOWN DIRECTIONAL TOTALS	163.3	0.0	6	0	0	24	0	0	33		495.0		0	0.0								

PROJECT NAME: **STATEWIDE-NORTH REGION**
PROJECT NUMBER: **STP HRRR(22)**

FILE NAME: **z14k100tssroxburv TH1 EB.xl**
PROJECT MANAGER: **K. RUTTER**
DESIGNED BY: **R. SHEDD**
ROXBURY TH-1 EASTBOUND 3

PLOT DATE: **5/5/2017**
DRAWN BY: **R. SHEDD**
CHECKED **S. GOODWIN**
SHEET **188** OF **255**