DIRECTION	MILEPOINT	LOCATION CODE (SHEET 4)	SIGN CODE	WIDTH (IN)	HEIGHT (IN)	SHEETING REMARKS	SIGN LEGEND	NEW SIGNS "A"	NEW SIGNS "B"	EXISTING SIGNS RETAIN	EXISTING SIGNS SALVAGE FROM	EXISTING SIGNS SALVAGE TO	EXISTING SIGNS REMOVE	EXIST POST RETAIN	EXIST POST REMOVE	NUMBER OF NEW POSTS	SQUARE STEEL (IN) 1.75 (LB / FT) 1.88	SQUARE STEEL (IN) 2.00 (LB / FT) 2.42	SQUARE STEEL (IN) 2.50 (LB / FT) 3.35	TUBULAR STEEL Ø (IN) FOUNDATION	TUBULAR STEEL Ø (IN) 3.00 (LB / FT) 7.60	TUBULAR STEEL Ø (IN) 3.50 (LB / FT) 9.00	TUBULAR STEEL Ø (IN) 4.00 (LB / FT) 10.80	TUBULAR STEEL Ø (IN) 5.00 (LB / FT) 14.60	SIGN FRAME REQUIRED	REMARKS	SIGN DETAIL LOCATION SHSM	SIGN DETAIL LOCATION SIGN DETAIL SHEET #	SIGN DETAIL LOCATION STANDARD SHEET #
SB WILLISTON TH-2							FY-FLUORESCENT YELLOW FYG-FLUORESCENT YELLOW GREEN																			"SHSM"-STANDARD HIGHWAY SIGNS AND MARKINGS BOOK			
SB	2.121	G	R2-1				SPEED LIMIT 35						1		X													
		G					STRICTLY ENFORCED (PLAQUE)						1																
SB	2.117	H	R1-1				STOP						1		X											5-7-18		
		H	R1-1	30	30			6.25								1		13.25 X									X	
SB	2.094	F	R2-1				SPEED LIMIT 40						1		X											5-1-18		
		F	R2-1	24	30			5.00								1		14.25 X									X	
SB	1.701	F					BLIND DRIVE AHEAD						1		X													
		F	VW-060	30	30			6.25								1		14.50 X										T-81
SB	1.475	F	W11-7				EQUESTRIAN WARNING						1		X													
		F	W11-7	30	30			6.25								1		13.75 X									X	
SB	1.450	F	R2-1				SPEED LIMIT 40						1		X													
SB	1.380	F	R2-1	24	30		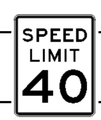	5.00								1		14.25 X									X	
SB	1.009	F	R2-1				SPEED LIMIT 40						1		X													
SB	0.507	F	R2-1				SPEED LIMIT 40						1		X													
		F	R2-1	24	30			5.00								1		14.75 X									X	
SIGN SUMMARY SHEET							SHEET TOTALS	33.75	0.00	0	0	0	9	0	0	6		84.75 ~~90.0~~		0	0.0	0.0	0.0	0.0					
								SF	SF	EA	EA	EA	EA	EA	EA	EA		FT		EA	LB	LB	LB	LB					
VERMONT AGENCY OF TRANSPORTATION							TOWN DIRECTIONAL TOTALS	108.2	0.0	0	0	0	14	0	0	19		285.0		0	0.0								

PROJECT NAME: **STATEWIDE-NORTH REGION**
PROJECT NUMBER: **STP HRRR(22)**

FILE NAME: **z14k100tsswilliston TH2 SB.x** PLOT DATE: **5/5/2017**
PROJECT MANAGER: **K. RUTTER** DRAWN BY: **R. SHEDD**
DESIGNED BY: **R. SHEDD** CHECKED **S. GOODWIN**
WILLISTON TH-2 SOUTHBOUND 2 SHEET **242** OF **255**