DIRECTION	MILEPOINT	LOCATION CODE (SHEET 4)	SIGN CODE	WIDTH (IN)	HEIGHT (IN)	SHEETING REMARKS	SIGN LEGEND	NEW SIGNS "A"	NEW SIGNS "B"	EXISTING SIGNS RETAIN	EXISTING SIGNS SALVAGE FROM	EXISTING SIGNS SALVAGE TO	EXISTING SIGNS REMOVE	EXIST POST RETAIN	EXIST POST REMOVE	NUMBER OF NEW POSTS	SQUARE STEEL (IN) (LB / FT) 1.75 / 1.88	2.00 / 2.42	2.50 / 3.35	TUBULAR STEEL Ø (IN) (LB / FT) FOUNDATION	3.00 / 7.60	3.50 / 9.00	4.00 / 10.80	5.00 / 14.60	SIGN FRAME REQUIRED	REMARKS	SIGN DETAIL LOCATION SHSM	SIGN DETAIL SHEET #	STANDARD SHEET #
SB WILLISTON TH-2							FY-FLUORESCENT YELLOW FYG-FLUORESCENT YELLOW GREEN																			"SHSM"-STANDARD HIGHWAY SIGNS AND MARKINGS BOOK			
SB	0.132	F	W3-1	30	30			6.25								1		14.50 X								5-1-18	X		
SB	0.094	F	M3-3	24	12			2.00								2		15.25 X 15.50							2C	SOUTH, GREEN ON WHITE			E-136B
		F	VM1-5	30	24		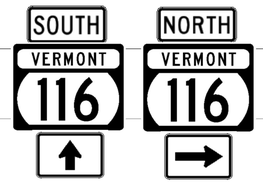	5.00																						E-136B
		F	M6-3	21	15			2.19																		UP ARROW, GREEN ON WHITE			E-136B
		F	M3-1	24	12			2.00																		NORTH, GREEN ON WHITE			E-136B
		F	VM1-5	30	24			5.00																					E-136B
		F	M6-1	21	15			2.19																		RIGHT ARROW, GREEN ON WHITE			E-136B
							SHEET TOTALS	24.63	0.00	0	0	0	0	0	0	3		45.25 ~~45.0~~		0	0.0	0.0	0.0	0.0					
								SF	SF	EA	EA	EA	EA	EA	EA	EA		FT		EA	LB	LB	LB	LB					
							TOWN DIRECTIONAL TOTALS	108.2	0.0	0	0	0	14	0	0	19		285.0		0	0.0								

SIGN SUMMARY SHEET

VERMONT AGENCY OF TRANSPORTATION

PROJECT NAME: STATEWIDE-NORTH REGION
PROJECT NUMBER: STP HRRR(22)
FILE NAME: z14k100tsswilliston TH2 SB.x
PLOT DATE: 5/5/2017
PROJECT MANAGER: K. RUTTER
DRAWN BY: R. SHEDD
DESIGNED BY: R. SHEDD
CHECKED BY: S. GOODWIN
WILLISTON TH-2 SOUTHBOUND 3
SHEET 243 OF 255