SPECIAL PROVISION (HAND–PLACED BITUMINOUS CONCRETE MATERIAL, DRIVES)

STATION	POSITION	TYPE	QUANTITY (SY)
A 428+48.	RT	GRAVEL	16.0
A 430+94.	LT	GRAVEL	9.0
A 431+96.	LT	PAVED	11.0
A 434+05.	LT	FIELD	6.0
A 435+07.	LT	PAVED	17.0
A 439+38.	LT	GRAVEL	10.0
A 442+04.	LT	GRAVEL	7.0
A 471+32.	LT	GRAVEL	17.0
A 471+47.	RT	GRAVEL	5.0
A 472+34.	LT	GRAVEL	58.0
A 473+27.	LT	GRAVEL	18.0
A 505+79.	RT	PAVED	74.0
A 506+58.	LT	GRAVEL	15.0
A 506+97.	LT	FIELD	6.0
A 516+07.	RT	GRAVEL	10.0
A 518+49.	RT	GRAVEL	11.0
A 529+86.	RT	GRAVEL	24.0
A 529+92.	LT	FIELD	7.0
A 567+50.	RT	GRAVEL	7.0
A 570+99.	RT	GRAVEL	11.0
A 585+35.	LT	PAVED	18.0
A 590+68.	RT	GRAVEL	33.0
A 609+46.	LT	GRAVEL	12.0
		SUBTOTAL =	402.0

STATION	POSITION	TYPE	QUANTITY (SY)
A 610+24.	LT	GRAVEL	11.0
A 611+61.	LT	GRAVEL	10.0
A 617+45.	RT	GRAVEL	16.0
A 618+21.	LT	GRAVEL	13.0
A 623+98.	LT	GRAVEL	19.0
A 634+30.	LT	GRAVEL	9.0
A 634+31.	RT	GRAVEL	18.0
A 634+87.	RT	GRAVEL	4.0
A 637+08.	RT	GRAVEL	19.0
A 640+68.	RT	GRAVEL	13.0
VT ROUTE 116 STARKSBORO			
B 1+63.	RT	GRAVEL	34.0
B 10+66.	RT	GRAVEL	13.0
B 24+71.	RT	GRAVEL	15.0
B 26+65.	RT	GRAVEL	20.0
B 27+79.	RT	GRAVEL	10.0
B 27+81.	LT	FIELD	8.0
B 29+46.	RT	GRAVEL	15.0
B 30+09.	RT	GRAVEL	11.0
B 32+20.	RT	GRAVEL	13.0
B 36+46.	RT	PAVED	8.0
B 38+06.	LT	GRAVEL	17.0
B 40+77.	LT	GRAVEL	6.0
		SUBTOTAL =	302.0

STATION	POSITION	TYPE	QUANTITY (SY)
B 42+42.	LT	GRAVEL	14.0
B 59+34.	LT	GRAVEL	29.0
B 63+65.	RT	GRAVEL	29.0
B 66+13.	RT	GRAVEL	26.0
B 70+46.	LT	FIELD	4.0
B 74+47.	LT	GRAVEL	65.0
B 75+90.	RT	GRAVEL	14.0
B 89+12.	RT	GRAVEL	21.0
B 94+09.	LT	GRAVEL	7.0
		SUBTOTAL =	5953.0
		ROUNDING =	97.0
		TOTAL =	6050.0

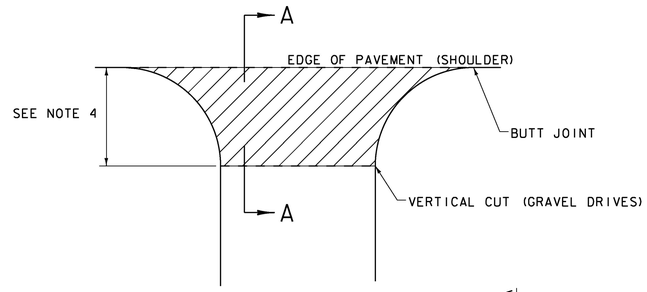

PLAN

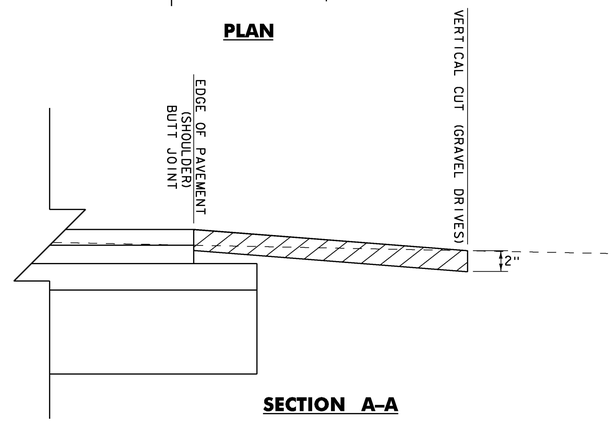

SECTION A–A

HANDWORK DETAILS FOR DRIVES – GRAVEL DRIVES

VT ROUTE 116

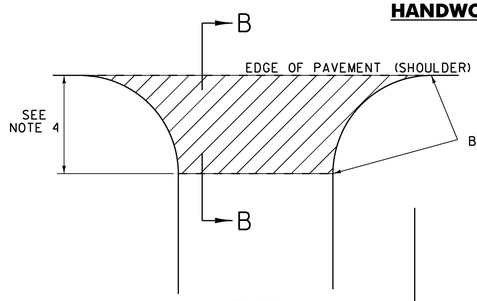

PLAN

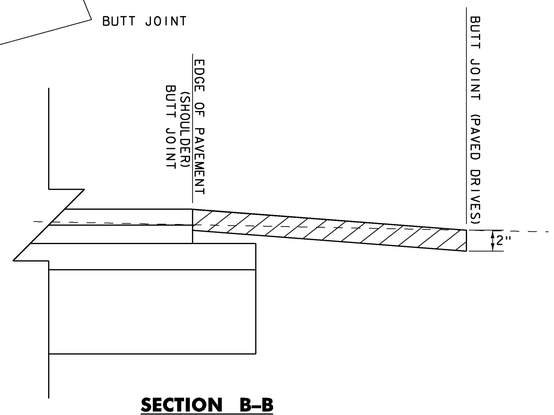

SECTION B–B

Sheet has not been updated.
See SiteManager / E-Books for locations
and quantities utilized on this project.

HANDWORK DETAILS FOR DRIVES – PAVED DRIVES

VT ROUTE 116

LEGEND

ITEM 900.675 "SPECIAL PROVISION (HAND-PLACED BITUMINOUS CONCRETE MATERIAL, DRIVES)"

NOT TO SCALE

NOTES:

1. PAVING LIFT NOT TO EXCEED TWO INCHES (50mm)
2. THE COST OF PLACING SUBBASE MATERIAL, CLEANING EXISTING PAVED SURFACES, INCLUDING POWER EQUIPMENT, AND FOR FILLING JOINTS, CRACKS AND HOLES WILL NOT BE PAID DIRECTLY BUT WILL BE CONSIDERED INCIDENTAL TO ITEM 900.675 "SPECIAL PROVISION (HAND-PLACED BITUMINOUS CONCRETE MATERIAL, DRIVES)".
3. EXCAVATION OR FILL NEEDED TO ACHIEVE PROPER DRIVE SLOPES WILL NOT BE PAID DIRECTLY BUT WILL BE CONSIDERED INCIDENTAL TO ITEM 900.675 "SPECIAL PROVISION (HAND-PLACED BITUMINOUS CONCRETE MATERIAL, DRIVES)".
4. FIELD DRIVES 2'-0"; RESIDENTIAL AND COMMERCIAL DRIVES 4'-0"; UNLESS OTHERWISE SHOWN ON THE PLANS OR AS DIRECTED BY THE ENGINEER.

PROJECT NAME:	MIDDLEBURY-STARKSBORO
PROJECT NUMBER:	STP 2953(I)
FILE NAME: zI4V227det.dgn	PLOT DATE: 5/4/2017
PROJECT LEADER: C.LATHROP	DRAWN BY: J. GOODALL
DESIGNED BY: J. GOODALL	CHECKED BY: C.LATHROP
HANDWORK DETAILS FOR DRIVES SHEET 4	SHEET 23 OF 186