BRISTOL SIGNS

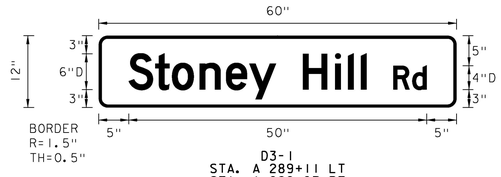

D3-1
STA. A 289+11 LT
STA. A 299+27 RT
WHITE ON GREEN

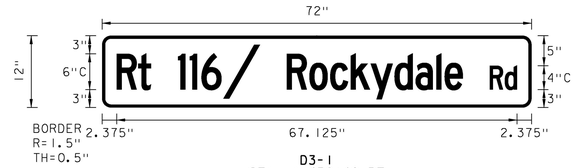

D3-1
STA. A 430+40 RT
WHITE ON GREEN

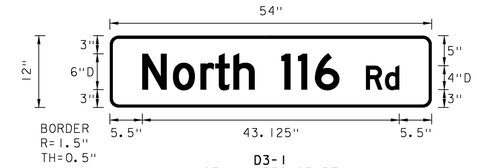

D3-1
STA. A 572+95 RT
WHITE ON GREEN

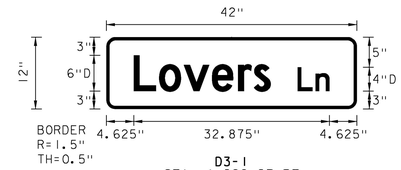

D3-1
STA. A 299+27 RT
WHITE ON GREEN

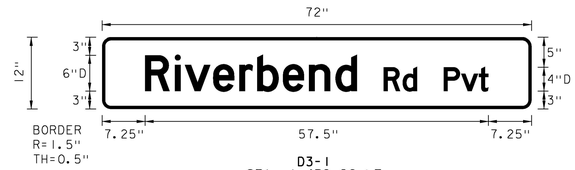

D3-1
STA. A 439+26 LT
WHITE ON GREEN

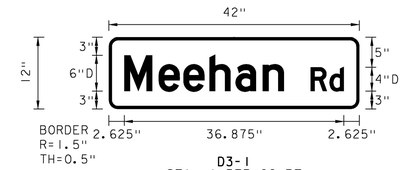

D3-1
STA. A 573+00 RT
WHITE ON GREEN

D3-1
STA. A 317+31 LT
WHITE ON GREEN

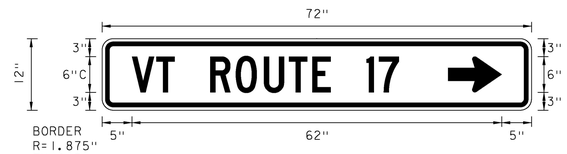

STA. A 511+88 RT
BLACK ON FLUORESCENT YELLOW

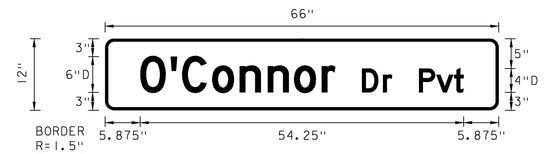

D3-1
STA. A 617+81 RT
WHITE ON GREEN

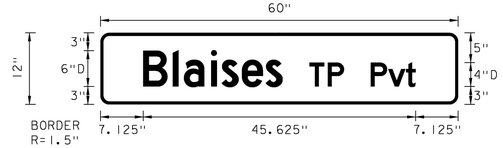

D3-1
STA. A 407+42 RT
WHITE ON GREEN

STA. A 511+88 RT
BLACK ON FLUORESCENT YELLOW

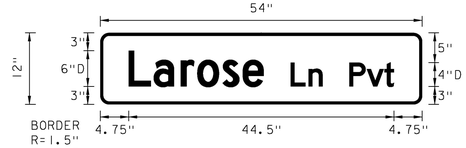

D3-1
STA. A 634+49 RT
WHITE ON GREEN

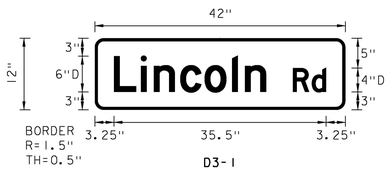

D3-1
STA. A 430+40 RT
WHITE ON GREEN

NOTE:
ALL STREET NAME SIGNS
ARE DOUBLE SIDED

KEY
R = RADIUS
TH = THICKNESS
IND = INDENT

NOT TO SCALE

PROJECT NAME: MIDDLEBURY-STARKSBORO	
PROJECT NUMBER: STP 2953(I)	
FILE NAME: zI4V227tsss.dgn	PLOT DATE: 5/4/2017
PROJECT LEADER: C.LATHROP	DRAWN BY: J. GOODALL
DESIGNED BY: J. GOODALL	CHECKED BY: C.LATHROP
SIGN DETAIL SHEET 3	SHEET 176 OF 186