DURABLE 4 INCH WHITE LINE (OPTION BID ITEM)
W 394+00 TO W 405+00 RT & LT

TEMPORARY 4 INCH WHITE LINE, PAINT
W 394+00 TO W 405+00 RT & LT

DURABLE 4 INCH YELLOW LINE (OPTION BID ITEM)
W 394+00 TO W 395+10 SOLID RT & LT
W 395+10 TO W 402+12 DASHED RT, SOLID LT
W 402+12 TO W 405+00 DASHED CL

TEMPORARY 4 INCH YELLOW LINE, PAINT
W 394+00 TO W 395+10 SOLID RT & LT
W 395+10 TO W 402+12 DASHED RT, SOLID LT
W 402+12 TO W 405+00 DASHED CL

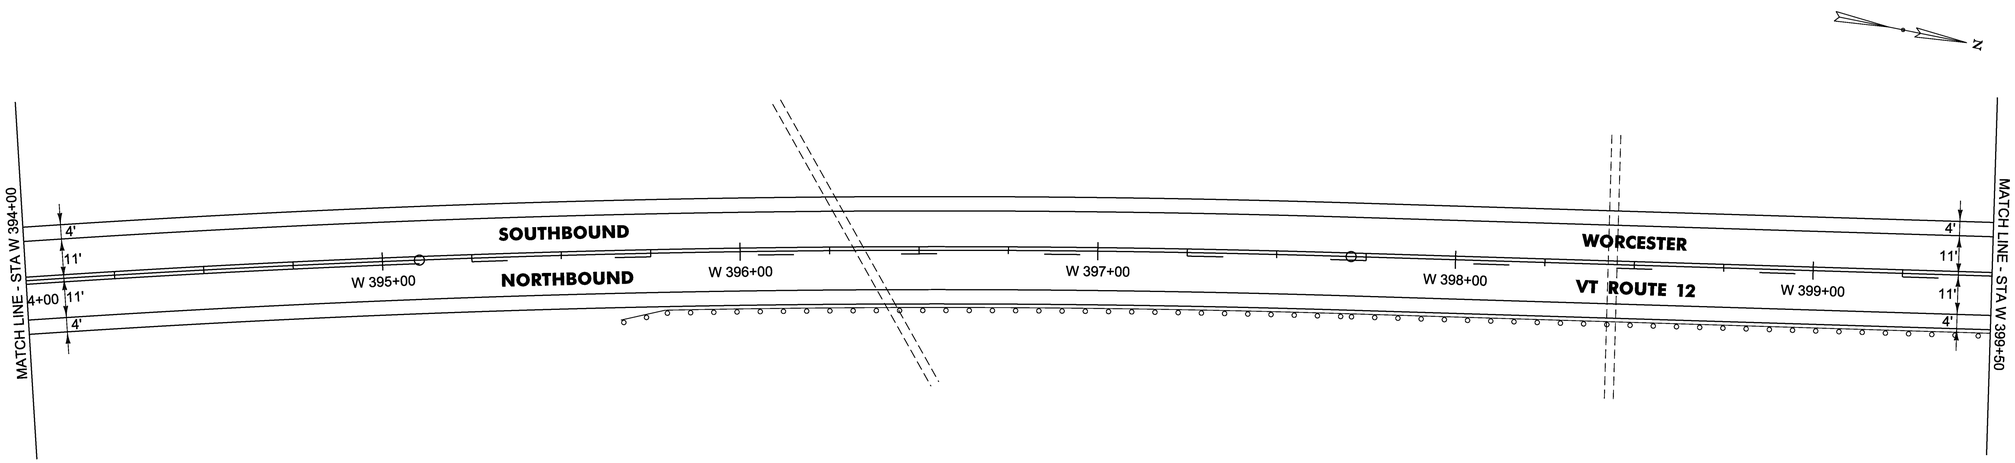

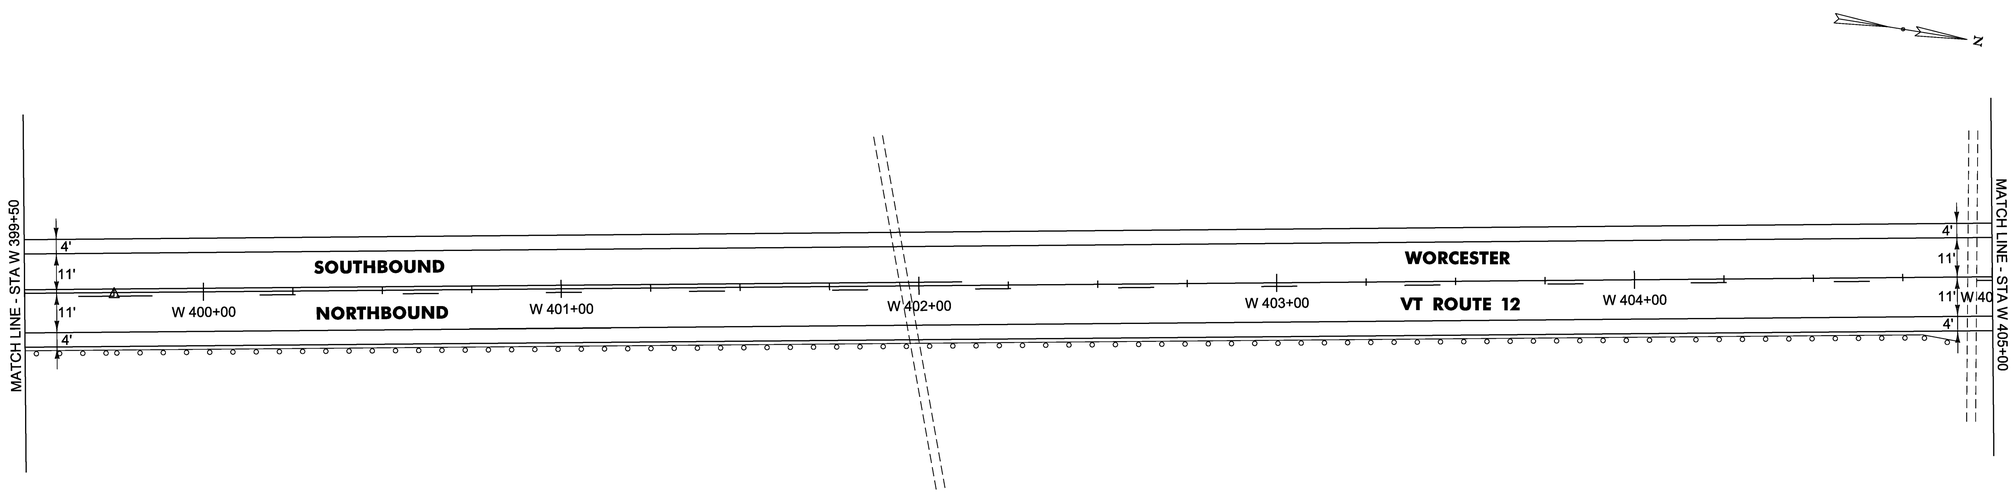

NOT TO SCALE

PROJECT NAME: WORCESTER-ELMORE	
PROJECT NUMBER: STP 2954(I)	
FILE NAME: pl4v23lwrk.dgn	PLOT DATE: 13-MAY-2016
PROJECT LEADER: J. HARRINGTON	DRAWN BY: B. KIPP
DESIGNED BY: B. KIPP	CHECKED BY: N. PAPPAS
PLAN SHEET 10	SHEET 20 OF 33