STATE OF VERMONT
AGENCY OF TRANSPORTATION

INDEX OF SHEETS

1	TITLE SHEET
2	CONVENTIONAL SYMBOLOGY LEGEND
3	TIE SHEET
4-5	GABION MATTRESS DETAIL SHEETS
6	QUANTITY SHEET
7-10	PLAN SHEETS
11	EROSION CONTROL DETAILS
12-16	GABION MATTRESS CROSS SECTION SHEETS
17	CONSTRUCTION APPROACH SIGNING

VAOT STANDARDS

T-1	08/06/12
T-10	08/06/12
T-17	08/06/12
T-28	08/06/12
T-29	08/06/12
T-30	08/06/12
T-31	08/06/12
T-35	08/06/12
T-36	08/06/12

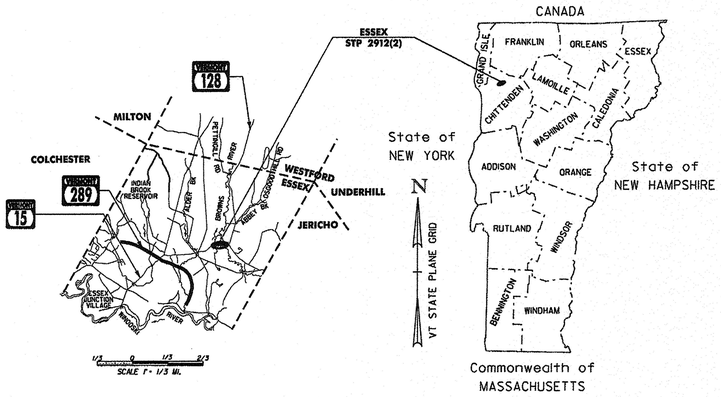

PROPOSED IMPROVEMENT
TOWN OF ESSEX
COUNTY OF CHITTENDEN
VT ROUTE 128 (MAJOR COLLECTOR)

BEGINNING IN THE TOWN OF ESSEX ON VT ROUTE 128 AT STA. 44+75.00 (MM 0.848) AND EXTENDING NORTHERLY ALONG VT ROUTE 128 FOR A DISTANCE OF 850.00 FEET (0.161 MILE) TO STA. 53+25.00 (MM 1.009) IN THE TOWN OF ESSEX.

PROJECT LENGTH:	LENGTH (FEET)	LENGTH (MILES)
TOTAL LENGTH OF PROJECT:	850.00	0.161
TOTAL LENGTH OF ROADWAY:	850.00	0.161

WORK TO BE PERFORMED UNDER THIS PROJECT INCLUDES GABION MATTRESS, STONE FILL, PAVING AND OTHER RELATED HIGHWAY ITEMS.

RECORD PLANS

CONTRACTOR: DON WESTON EXCAVATING, INC. – WILLISTON, VT

RESIDENT ENGINEER: CHRIS ACHILLES

CONSTRUCTION BEGAN: OCTOBER 15, 2015

CONSTRUCTION COMPLETE: SEPTEMBER 20, 2016

RECORD PLANS BY: CHRIS ACHILLES & AARON WEAVER

I HEREBY CERTIFY THAT ALL THE CONSTRUCTION REQUIRED BY THIS SET OF DRAWINGS HAS BEEN ACCOMPLISHED AS INDICATED HEREIN.

BY _____ RESIDENT ENGINEER

DATE 6/3/18

NOTE: Any further information concerning final quantities, amounts or other details relative to this project may be found at Central Files in the electronic archives.

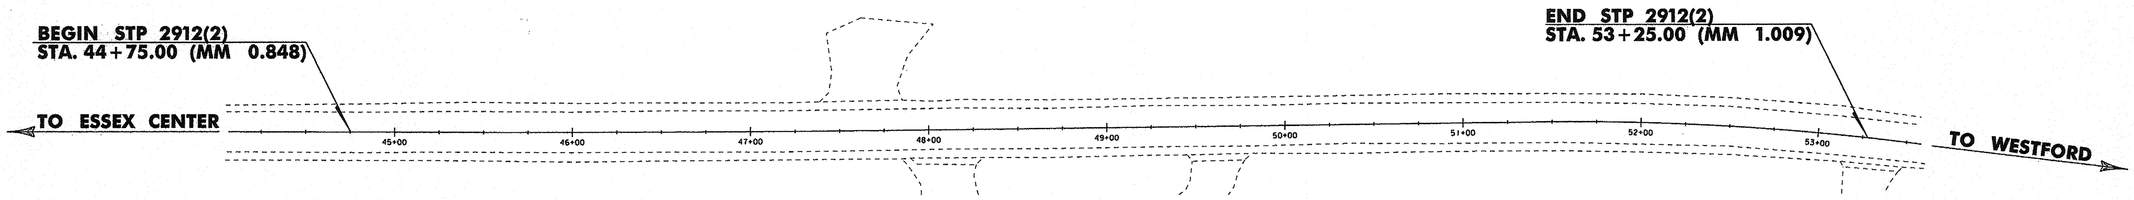

CONSTRUCTION IS TO BE CARRIED ON IN ACCORDANCE WITH THESE PLANS AND THE STANDARD SPECIFICATIONS FOR CONSTRUCTION DATED 2011, AS APPROVED BY THE FEDERAL HIGHWAY ADMINISTRATION ON JULY 20, 2011 FOR USE ON THIS PROJECT, INCLUDING ALL SUBSEQUENT REVISIONS AND SUCH REVISED SPECIFICATIONS AND SPECIAL PROVISIONS AS ARE INCORPORATED IN THESE PLANS.

0 40 80
SCALE IN FEET

N
VT STATE PLANE GRID

QUALITY ASSURANCE PROGRAM : LEVEL 2

SURVEYED BY : L. ORVIS - VTRANS
SURVEYED DATE : 07/2014

DATUM
VERTICAL NAVD88
HORIZONTAL NAD83

TRAFFIC DATA

LOCATION	AADT		DHV		ESALS	
	2015	2025	2015	2025	2015-2025	2015-2035
BEGIN PROJECT TO WEED ROAD (TH-63)	3800	3900	430	440	607,000	1,288,000

DIRECTOR OF PROJECT DELIVERY
APPROVED _____ DATE 6/17/2015

PROJECT MANAGER : MICHAEL J. FOWLER, P.E.

PROJECT NAME : ESSEX
PROJECT NUMBER : STP 2912(2)

SHEET 1 OF 17 SHEETS