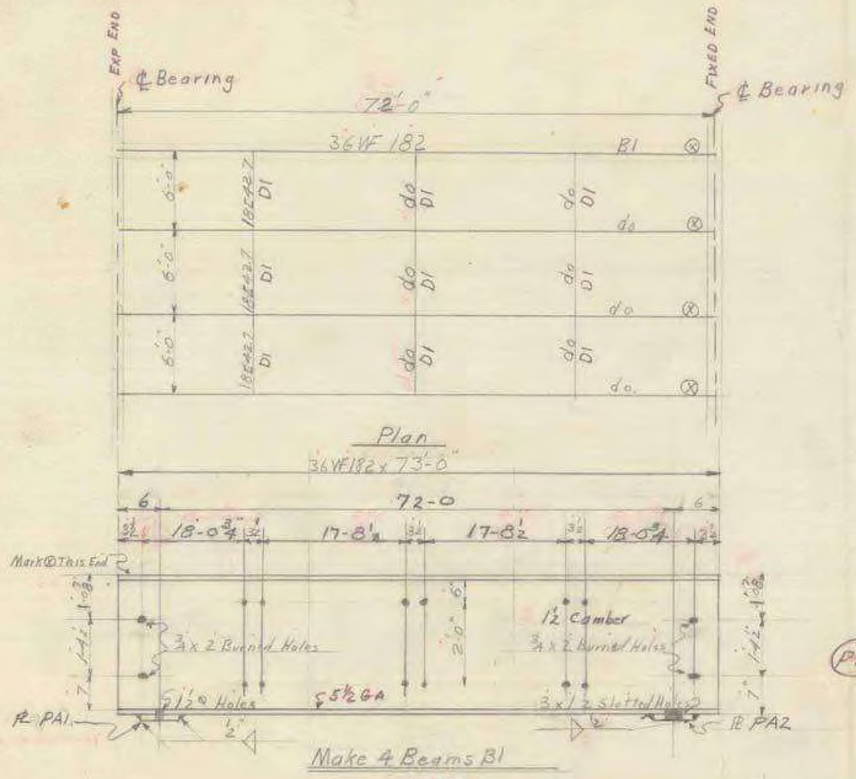

Make 4 Beams B1

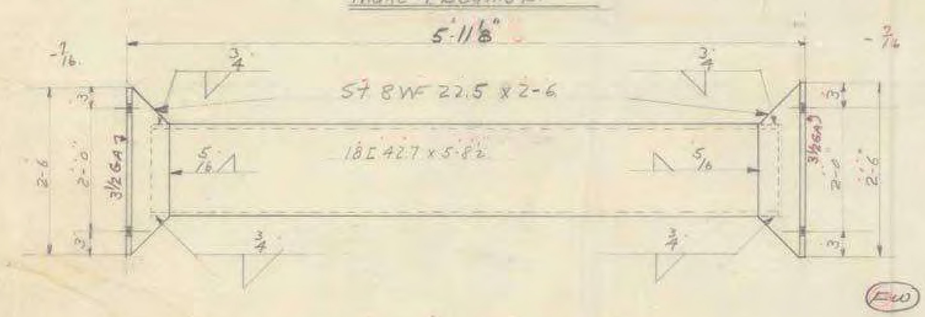

Make 9 Diaphragms D1

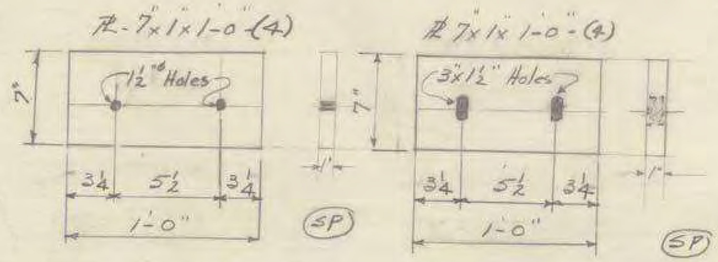

Make 4 Plates - PA1

Make 4 Plates PA2

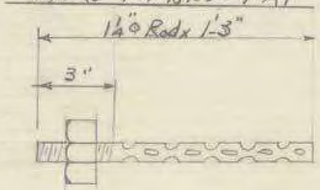

Make 16 Swedge Bolts

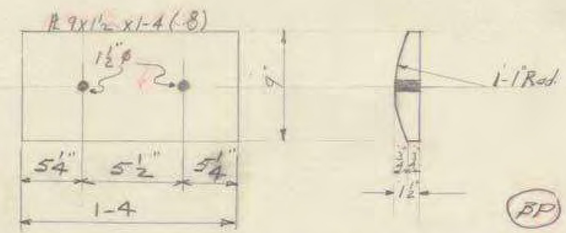

Make 8 Bearing Plates BP1

	VERMONT STRUCTURAL STEEL CORPORATION BURLINGTON, VT.
REVISIONS	BLDG. Haughs Crossing Bridge
	PROJ. Orwell, Vermont SA 26-1946
	CONTR. Town of Orwell, VT
	HOLES 9/16 MADE BY F.G.H.
	RIVETS 1/2 CHECKED BY [illegible]
	PAINT R. Lead - VT Spec. DATE 6-5-47
	JOB No. 636 SHEET No. 1

ORWELL
STP DECK(41)
BRIDGE NO. 4
SHEET 26 OF 27
FOR REFERENCE ONLY