DIRECTION	MILEPOINT	LOCATION CODE (SHEET 2)	SIGN CODE	WIDTH (IN)	HEIGHT (IN)	SHEETING REMARKS	SIGN LEGEND	NEW SIGNS "A"	NEW SIGNS "B"	EXISTING SIGNS RETAIN	EXISTING SIGNS SALVAGE FROM	EXISTING SIGNS SALVAGE TO	EXISTING SIGNS REMOVE	EXIST POST RETAIN	EXIST POST REMOVE	NUMBER OF NEW POSTS	SQUARE STEEL (IN) 1.75 (LB/FT) 1.88	SQUARE STEEL (IN) 2.00 (LB/FT) 2.42	SQUARE STEEL (IN) 2.50 (LB/FT) 3.35	TUBULAR STEEL Ø (IN) FOUNDATION	TUBULAR STEEL Ø (IN) 3.00 (LB/FT) 7.60	TUBULAR STEEL Ø (IN) 3.50 (LB/FT) 9.00	TUBULAR STEEL Ø (IN) 4.00 (LB/FT) 10.80	TUBULAR STEEL Ø (IN) 5.00 (LB/FT) 14.60	SIGN FRAME REQUIRED	REMARKS	SIGN DETAIL LOCATION SHSM	SIGN DETAIL LOCATION PROJECT SHEET #	SIGN DETAIL LOCATION STANDARD SHEET #
WINOOSKI VT-15 WB							FY-FLUORESCENT YELLOW FYG-FLUORESCENT YELLOW GREEN																				"SHSM"-STANDARD HIGHWAY SIGNS AND MARKINGS			
WB	0.365	F	R15-1				~~CROSSBUCK~~						1																
		F	UNK.	12	9		~~REPORT PROBLEM RR X-ING~~						1																
		F	R15-1	48	9			3.00																MOUNT NEW SIGNS ON EXISTING RAILROAD SIGNAL POLE; OVERLAY THE ENTIRE BACK OF CROSSBUCK SIGN WITH REFLECTIVE SHEETING; SEE NOTES & DETAIL ON SHEET 16	X		
		F	I-13a	30	18		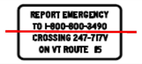	3.75																				16	
		F	UNK.	9	4			0.25																			DID NOT DO WORK RELATED TO R.R. AS PER P.M..		16	
WB	0.350	F	R8-3	12	12		NO PARKING						1		X														
		F	R8-3	24	24			4.00								1		X								INSTALLED PER ADDENDUM TO CHAPTER 21 OF PARKING ORDINANCES	X		
WB	0.330	F	R3-9cP	24	12		BEGIN						1		X														
		F	R3-9b	24	36		CENTER TURNING LANE ONLY				1		1																
		F	R8-3	12	12		NO PARKING						1																
		F	R3-9cP	30	12			2.50								1		X								THINNING AND TRIMMING NEEDED	X		
		F	R3-9b	24	36		CENTER TURNING LANE ONLY					1																
		F	R8-3	24	24			4.00								1		X								INSTALLED PER ADDENDUM TO CHAPTER 21 OF PARKING ORDINANCES	X		
WB	0.290	F	R3-9b	24	36		CENTER TURNING LANE ONLY			1				X														
		F	R8-3	12	12		NO PARKING						1														THINNING AND TRIMMING NEEDED			
SIGN SUMMARY SHEET							SHEET TOTALS	17.50	0.00	1	1	1	7	0	0	2		30.0		0	0.0	0.0	0.0	0.0					
								SF	SF	EA	EA	EA	EA	EA	EA	EA		FT		EA	LB	LB	LB	LB					
VERMONT AGENCY OF TRANSPORTATION							TOWN DIRECTIONAL TOTALS	282.75	0.0	29	15	15	98	0	0	30		450.0		1	118.0								

PROJECT NAME: **WINOOSKI-CAMBRIDGE**
PROJECT NUMBER: **STPG SIGN(55)**

FILE NAME: **WINOOSKI VT15 WB TSS.xls** PLOT DATE: **6/14/2016**
PROJECT MANAGER: **M. FOISY** DRAWN BY: **D. DRAPER**
DESIGNED BY: **D. DRAPER** CHECKED **M. FOISY**
WINOOSKI WB SHEET 9 SHEET **43** OF **192**