DIRECTION	MILEPOINT	LOCATION CODE (SHEET 2)	SIGN CODE	WIDTH (IN)	HEIGHT (IN)	SHEETING REMARKS	SIGN LEGEND	NEW SIGNS		EXISTING SIGNS				EXIST POST		NUMBER OF NEW POSTS	SQUARE STEEL (IN)			TUBULAR STEEL Ø (IN)				SIGN FRAME REQUIRED	REMARKS	SIGN DETAIL LOCATION		
								"A"	"B"	RETAIN	SALVAGE FROM	SALVAGE TO	REMOVE	RETAIN	REMOVE		1.75 (LB / FT) 1.88	2.00 (LB / FT) 2.42	2.50 (LB / FT) 3.35	FOUNDATION	3.00 (LB / FT) 7.60	3.50 (LB / FT) 9.00	4.00 (LB / FT) 10.80	5.00 (LB / FT) 14.60			SHSM	PROJECT SHEET #	STANDARD SHEET #
COLCHESTER VT-15 EB							FY-FLUORESCENT YELLOW FYG-FLUORESCENT YELLOW GREEN																		"SHSM"-STANDARD HIGHWAY SIGNS AND MARKINGS			
		K	OM1-1	18	18		YELLOW CLUSTER						1															
		J	R4-7	24	30		RIGHT BULLNOSE					1				1		X										
		J	OM1-1	18	18		YELLOW CLUSTER					1																
		K	R3-4	24	24		NO U TURN					1														X		
		K	OM1-1	18	18			2.25																		X		
EB	0.368	J	R3-4	24	24		NO U TURN				1		1		X													
		J	OM1-1	18	18		YELLOW CLUSTER						1															
		K	R4-7	24	30		RIGHT BULLNOSE						1															
		K	OM1-1	18	18		YELLOW CLUSTER						1															
		J	R3-4	36	36		NO U TURN					1				1		X								X		
		J	OM1-1	18	18			2.25																		X		
		K	R4-7	24	30		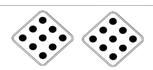	5.00																		X		
		K	OM1-1	18	18			2.25																		X		
SIGN SUMMARY SHEET							SHEET TOTALS	11.75 SF	0.00 SF	0 EA	1 EA	4 EA	5 EA	0 EA	0 EA	2 EA	30.0 FT			0 EA	0.0 LB	0.0 LB	0.0 LB	0.0 LB					
VERMONT AGENCY OF TRANSPORTATION							TOWN DIRECTIONAL TOTALS	554.28	0.0	43	12	12	91	0	0	41	615.0			0	0.0									

PROJECT NAME: **WINOOSKI - CAMBRIDGE**
PROJECT NUMBER: **STPG SIGN(55)**

FILE NAME: **COLCHESTER VT15 EB TSS.x** PLOT DATE: **6/14/2016**
PROJECT MANAGER: **M. FOISY** DRAWN BY: **G. BARRETT**
DESIGNED BY: **G. BARRETT** CHECKED **M. FOISY**
COLCHESTER EB SHEET 3 SHEET **52** OF **192**