DIRECTION	MILEPOINT	LOCATION CODE (SHEET 2)	SIGN CODE	WIDTH (IN)	HEIGHT (IN)	SHEETING REMARKS	SIGN LEGEND	NEW SIGNS "A"	NEW SIGNS "B"	EXISTING SIGNS RETAIN	EXISTING SIGNS SALVAGE FROM	EXISTING SIGNS SALVAGE TO	EXISTING SIGNS REMOVE	EXIST POST RETAIN	EXIST POST REMOVE	NUMBER OF NEW POSTS	SQUARE STEEL (IN) 1.75 (LB / FT) 1.88	SQUARE STEEL (IN) 2.00 (LB / FT) 2.42	SQUARE STEEL (IN) 2.50 (LB / FT) 3.35	TUBULAR STEEL Ø (IN) FOUNDATION	TUBULAR STEEL Ø (IN) 3.00 (LB / FT) 7.60	TUBULAR STEEL Ø (IN) 3.50 (LB / FT) 9.00	TUBULAR STEEL Ø (IN) 4.00 (LB / FT) 10.80	TUBULAR STEEL Ø (IN) 5.00 (LB / FT) 14.60	SIGN FRAME REQUIRED	REMARKS	SIGN DETAIL LOCATION SHSM	SIGN DETAIL LOCATION PROJECT SHEET #	SIGN DETAIL LOCATION STANDARD SHEET #
COLCHESTER VT-15 EB							FY-FLUORESCENT YELLOW FYG-FLUORESCENT YELLOW GREEN																			"SHSM"-STANDARD HIGHWAY SIGNS AND MARKINGS			
		J	R4-7	24	30			5.00																			X		
		J	OM1-1	18	18			2.25																			X		
		K	R3-4	36	36		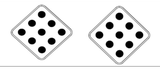	9.00																			X		
		K	OM1-1	18	18			2.25																			X		
EB	0.838	A	VD1-1	72	10		CAMP JOHNSON ---> (45 DEG)						1		X														
		A	R3-23	60	36			15.00								2		X							X		
EB	0.893	A	VR-284	36	30		ALL TURNS ===> (45 DEG)						1		X														
		A	VD1-1	72	12			6.00								2		X									T-93
		A	R3-24	72	18			9.00																			X		
EB	0.903	A	R1-1	30	30		STOP			1				X													THINNING AND TRIMMING NEEDED		
EB	0.903	A	R1-1	30	30		STOP			1				X															
EB	0.903	A	R1-1	30	30		STOP						1		X														
		A	R1-1	30	30			6.25																			REMOVE AND REPLACE STOP SIGN ON RIGHT SIDE OF EXIT ROAD FROM THE HOSPITAL		
EB	0.915	A	R3-23a	60	36			15.00								2		X									INSTALL 105 FEET FROM STOP SIGNS ON JUGHANDLE. SEE SHEET 5 FOR DETAIL	X		
		A	R3-23a	60	36			15.00								2		X										X		
SIGN SUMMARY SHEET							SHEET TOTALS	84.75	0.00	2	0	0	3	0	0	8		120.0		0	0.0	0.0	0.0	0.0				
								SF	SF	EA	EA	EA	EA	EA	EA	EA		FT		EA	LB	LB	LB	LB				
VERMONT AGENCY OF TRANSPORTATION							TOWN DIRECTIONAL TOTALS	554.28	0.0	43	12	12	91	0	0	41		615.0		0	0.0							

PROJECT NAME: **WINOOSKI - CAMBRIDGE**
PROJECT NUMBER: **STPG SIGN(55)**

FILE NAME: **COLCHESTER VT15 EB TSS.x** PLOT DATE: **6/14/2016**
PROJECT MANAGER: **M. FOISY** DRAWN BY: **G. BARRETT**
DESIGNED BY: **G. BARRETT** CHECKED **M. FOISY**
COLCHESTER EB SHEET 12 SHEET **61** OF **192**