DIR	MILEPOINT	LOCATION CODE	MUTCD CODE	WIDTH	HEIGHT	SHEETING REMARKS	SIGN LEGEND	NEW SIGNS "A"	NEW SIGNS "B"	EXISTING SIGNS RETAIN	EXISTING SIGNS SALVAGE FROM	EXISTING SIGNS SALVAGE TO	EXISTING SIGNS REMOVE	EXIST POST RETAIN	EXIST POST REMOVE	NUMBER OF NEW POSTS	SQUARE STEEL (in) 1.75 (LB / FT) 1.88	SQUARE STEEL (in) 2.00 (LB / FT) 2.42	SQUARE STEEL (in) 2.50 (LB / FT) 3.35	FOUNDATION	TUBULAR STEEL Ø (IN) 3.00 (LB / FT) 7.60	TUBULAR STEEL Ø (IN) 3.50 (LB / FT) 9.00	TUBULAR STEEL Ø (IN) 4.00 (LB / FT) 10.80	TUBULAR STEEL Ø (IN) 5.00 (LB / FT) 14.60	SIGN FRAME REQUIRED	REMARKS	SIGN DETAIL: DETAIL IN SHSM	SIGN DETAIL: DETAIL ON SHEET NUMBER	SIGN DETAIL: DETAIL ON STD SHEET NUMBER
SUTTON			**US5**	**NB**			FYG-FLUORESCENT YELLOW-GREEN																			"SHSM" - STANDARD HIGHWAY SIGNS AND MARKINGS			
NB	5.195	A	W11-21	30	30		MOOSE CROSSING						1		1													
		A	W7-3aP	24	18		NEXT 2 MILES						1					14'-6"										
		A	VW-000	30	30			6.25								1		X										T-80
		A	W7-3aP	24	18			3.00																			X		
NB	5.213	A	VD3-1	60	12			5.00								2		12'-6" X 12'-3"								INSTALL PROPOSED SIGN 338 FEET SOUTH OF STOP SIGN ON SOUTH SIDE OF MARL POND RD		16	
NB	5.222	C	VR-017	24	30			5.00								1		13'-0" X								INSTALL SIGN 20 FEET MINIMUM FROM US 5 EDGE OF PAVEMENT			T-70
NB	5.213 ~~5.227~~	D	R1-1	30	30		STOP						1		1													
		D	R1-1	30	30		MOUNTED STOP TO MARL POND RD. STREET SIGN	6.25								1		13'-9" X									X		
NB	6.276	A	W2-3	30	30		MODIFIED 135 DEG ANGLE						1		1													
		A	W16-8P	24	8		UNDERPASS RD						1															
		A	W2-3	30	30			6.25								1		12'-9" X 12'-3"									X		
		A	W16-8P	24	8		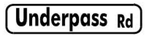	1.33																				6	
NB	6.345	A	VD1-1A	54	10		<--- SUTTON 5						1		2													
		A	VD1-1A	72	12			6.00								2		X										7	
NB	6.417	A	M3-1	24	12		NORTH						1	1														
							SHEET TOTALS	39.08 SF	0.00 SF	0 EA	0 EA	0 EA	7 EA	1 EA	5 EA	8 EA		120 FT											
							TOWN TOTALS	121.08	0.0	8.0	0.0	0.0	22.0	7.0	16.0	23		345.0											

10/5/16

10/17/16

SIGN SUMMARY SHEET

VERMONT AGENCY OF TRANSPORTATION

PROJECT NAME: **STATEWIDE- NORTHEAST**
PROJECT NUMBER: **STPG SIGN(56)**

FILE NAME: **z15T007 US5-SUTTON-NB.xls** PLOT DATE: **5/4/2016**
PROJECT MANAGER: **B. BRESLEND** DRAWN BY: **O. DALMER**
DESIGNED BY: **O. DALMER** CHECKED BY: **B. BRESLEND**
SUTTON US5 NB 3 SHEET **44** OF **168**