	DIR	MILEPOINT	LOCATION CODE	MUTCD CODE	WIDTH	HEIGHT	SHEETING REMARKS	SIGN LEGEND	NEW SIGNS "A"	NEW SIGNS "B"	EXISTING SIGNS RETAIN	EXISTING SIGNS SALVAGE FROM	EXISTING SIGNS SALVAGE TO	EXISTING SIGNS REMOVE	EXIST POST RETAIN	EXIST POST REMOVE	NUMBER OF NEW POSTS	SQUARE STEEL (in) 1.75 (LB / FT) 1.88	SQUARE STEEL (in) 2.00 (LB / FT) 2.42	SQUARE STEEL (in) 2.50 (LB / FT) 3.35	FOUNDATION	TUBULAR STEEL Ø (IN) 3.00 (LB / FT) 7.60	TUBULAR STEEL Ø (IN) 3.50 (LB / FT) 9.00	TUBULAR STEEL Ø (IN) 4.00 (LB / FT) 10.80	TUBULAR STEEL Ø (IN) 5.00 (LB / FT) 14.60	SIGN FRAME REQUIRED	REMARKS	SIGN DETAIL: DETAIL IN SHSM	SIGN DETAIL: DETAIL ON SHEET NUMBER	SIGN DETAIL: DETAIL ON STD SHEET NUMBER
	SUTTON			**US5**	**SB**			FYG-FLUORESCENT YELLOW-GREEN																			"SHSM" - STANDARD HIGHWAY SIGNS AND MARKINGS			
	SB	7.327	F	VW-619	30	30		SHOULDER NARROWS			1				1														
	SB	7.277	F	VW-000	30	30		MOOSE CROSSING						1		1													
			F	W7-3aP	24	18		NEXT 2 MILES						1															
10/17/16			F	VW-000	30	30			6.25								1	15'-0" X											T-80
			F	W7-3aP	24	18			3.00																		X		
	SB	7.209	F	VD-701	6	8		BRIDGE 154 VT US 5			1				1														
	SB	6.953	F	VW-054	30	30		HIDDEN DRIVE RIGHT						1		1													
			F	VW-054	30	30			6.25								1	14'-9" X											T-81
	SB	6.485	F	W2-3	30	30		MODIFIED 45 DEG ANGLE RIGHT						1	~~1~~	1													
			F	W16-8P	24	8		UNDERPASS RD						1															
10/17/16			F	W2-3R	30	30			6.25								1	16'-0" X									X		
			F	W16-8P	24	8		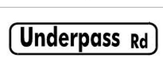	1.33																			6	
	SB	6.432	F	VD1-1A	72	12		SUTTON 5 --->						1	~~2~~	2													
			F	VD1-1A	72	12		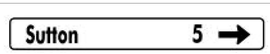	6.00								2	14'-0" X 13'-0"										7	
	SB	6.382	G	VR-017	24	30		LLL 24,000 LBS						1		1													
								SHEET TOTALS	29.08	0.00	2	0	0	7	5	3	2		30										
									SF	SF	EA	EA	EA	EA	EA	EA	EA		FT										
								TOWN TOTALS	103.83	0.0	6.0	2.0	2.0	20.0	9.0	13.0	18		270.0										

SIGN SUMMARY SHEET

VERMONT AGENCY OF TRANSPORTATION

PROJECT NAME: STATEWIDE- NORTHEAST
PROJECT NUMBER: STPG SIGN(56)

FILE NAME: z15T007 US5-SUTTON-SB.xls
PROJECT MANAGER: B. BRESLEND
DESIGNED BY: O. DALMER
SUTTON US5 SB 1

PLOT DATE: 5/4/2016
DRAWN BY: O. DALMER
CHECKED BY: B. BRESLEND
SHEET 46 OF 168