	DIR	MILEPOINT	LOCATION CODE	MUTCD CODE	WIDTH	HEIGHT	SHEETING REMARKS	SIGN LEGEND	NEW SIGNS "A"	NEW SIGNS "B"	EXISTING SIGNS RETAIN	EXISTING SIGNS SALVAGE FROM	EXISTING SIGNS SALVAGE TO	EXISTING SIGNS REMOVE	EXIST POST RETAIN	EXIST POST REMOVE	NUMBER OF NEW POSTS	SQUARE STEEL (in) 1.75 (LB / FT) 1.88	SQUARE STEEL (in) 2.00 (LB / FT) 2.42	SQUARE STEEL (in) 2.50 (LB / FT) 3.35	TUBULAR STEEL Ø (IN) FOUNDATION	TUBULAR STEEL Ø (IN) 3.00 (LB / FT) 7.60	TUBULAR STEEL Ø (IN) 3.50 (LB / FT) 9.00	TUBULAR STEEL Ø (IN) 4.00 (LB / FT) 10.80	TUBULAR STEEL Ø (IN) 5.00 (LB / FT) 14.60	SIGN FRAME REQUIRED	REMARKS	SIGN DETAIL: DETAIL IN SHSM	SIGN DETAIL: DETAIL ON SHEET NUMBER	SIGN DETAIL: DETAIL ON STD SHEET NUMBER
	BURKE			**VT5A**	**SB**			FYG-FLUORESCENT YELLOW-GREEN																			"SHSM" - STANDARD HIGHWAY SIGNS AND MARKINGS			
9/29/16	SB	0.654	A	W3-5a	36	36		35 MPH AHEAD						1		2													
			A	W3-5	36	36			9.00								2		16'-0" X 15'-3"								X		
	SB	0.593	A	VD-018	30	18		WEST BURKE JCT US - 5						1		1													
			A	VD-018	30	18		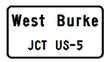	3.75								1		13'-9" X									6	
	SB	0.516	A	R2-1	30	36		SPEED LIMIT 35						1		1													
			A	R2-1	30	36			7.50								1		15'-3" X								X		
	SB	0.443	A	VD-062C	74.75	16		D BOARD			1				2														
			A	VD-062BC	7475	16		TRAVEL INFORMATION UP^ ON RIGHT AT US 5 1/2			1																		
9/30/16	SB	0.421	A	VD-701	6	8		BRIDGE 3 VT 5A			1				1														
	SB	0.405	A	VD3-1	66	12		N RIDGE RD			1				1													REQUIRES VEGETATION CLEARING		
	SB	0.399	G	VR-017	24	30		LLL 24,000 LBS			1				1														
	SB	0.391	H	R1-1	30	30		STOP						1		1													
			G	VD-700	6	10		MM 0051, 0302, 0039				1	1	1			1		13'-3" X								SALVAGE SIGN ON NEW POST IN EXISTING LOCATION		
			H	R1-1	30	30			6.25																		X		
	SB	0.346	A	VD-701	6	8		BRIDGE 2 VT 5A			1				1														
								SHEET TOTALS	26.50	0.00	6	1	1	5	6	5	5		75		0	0							
									SF	SF	EA	EA	EA	EA	EA	EA	EA		FT										
								TOWN TOTALS	132.32	0.0	8.0	4.0	4.0	31.0	8.0	17.0	18		240.0		2	304							

SIGN SUMMARY SHEET

VERMONT AGENCY OF TRANSPORTATION

PROJECT NAME: **STATEWIDE- NORTHEAST**
PROJECT NUMBER: **STPG SIGN(56)**

FILE NAME: **z15T007VT5A-BURKE-SB.xls** PLOT DATE: **5/4/2016**
PROJECT MANAGER: **B. BRESLEND** DRAWN BY: **O. DALMER**
DESIGNED BY: **O. DALMER** CHECKED BY: **B. BRESLEND**
BURKE VT5A SB 1 SHEET **63** OF **168**