DIR	MILEPOINT	LOCATION CODE	MUTCD CODE	WIDTH	HEIGHT	SHEETING REMARKS	SIGN LEGEND	NEW SIGNS "A"	NEW SIGNS "B"	EXISTING SIGNS RETAIN	EXISTING SIGNS SALVAGE FROM	EXISTING SIGNS SALVAGE TO	EXISTING SIGNS REMOVE	EXIST POST RETAIN	EXIST POST REMOVE	NUMBER OF NEW POSTS	SQUARE STEEL (in) 1.75 (LB / FT) 1.88	SQUARE STEEL (in) 2.00 (LB / FT) 2.42	SQUARE STEEL (in) 2.50 (LB / FT) 3.35	FOUNDATION	TUBULAR STEEL Ø (IN) 3.00 (LB / FT) 7.60	TUBULAR STEEL Ø (IN) 3.50 (LB / FT) 9.00	TUBULAR STEEL Ø (IN) 4.00 (LB / FT) 10.80	TUBULAR STEEL Ø (IN) 5.00 (LB / FT) 14.60	SIGN FRAME REQUIRED	REMARKS	SIGN DETAIL: DETAIL IN SHSM	SIGN DETAIL: DETAIL ON SHEET NUMBER	SIGN DETAIL: DETAIL ON STD SHEET NUMBER
BURKE			**VT5A**	**SB**			FYG-FLUORESCENT YELLOW-GREEN																			"SHSM" - STANDARD HIGHWAY SIGNS AND MARKINGS			
SB	0.038	A	D1-1a	72	12		<--- LYNDONVILLE 8						1		2														
		A	D1-1a	72	12		<--- ST JOHNSBURY 17						1																
		A	D1-1a	72	12		BARTON 13 --->						1																
		A	M3-3	24	12		SOUTH						1																
		A	M1-4	24	24		US 5						1																
		A	M6-1L	21	15		<--- LEFT						1																
		A	M3-1	24	12		NORTH						1																
		A	M1-4	24	24		US 5						1																
		A	M6-1R	21	15		<--- RIGHT						1																
		A	D1-1a	72	12		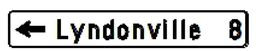	6.00								2				2	216.6 ~~304~~							10	
		A	D1-1a	72	12		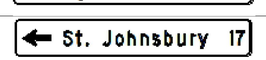	6.00																				10	
		A	D1-1a	72	12		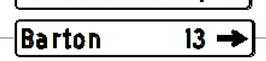	6.00																				10	
		A	M3-3	24	12			2.00																			BLACK ON WHITE	X		
		A	M1-4	24	24			4.00																				X		
		A	M6-1L	21	15			2.19																			BLACK ON WHITE	X		
							SHEET TOTALS	26.19 SF	0.00 SF	0 EA	0 EA	0 EA	9 EA	0 EA	2 EA	2 EA	0 FT			2	304					
							TOWN TOTALS	132.32	0.0	8.0	4.0	4.0	31.0	8.0	17.0	18	240.0			2	304					

11/11/16

SIGN SUMMARY SHEET

VERMONT AGENCY OF TRANSPORTATION

PROJECT NAME: STATEWIDE- NORTHEAST
PROJECT NUMBER: STPG SIGN(56)
FILE NAME: z15T007VT5A-BURKE-SB.xls
PROJECT MANAGER: B. BRESLEND
DESIGNED BY: O. DALMER
PLOT DATE: 5/4/2016
DRAWN BY: O. DALMER
CHECKED BY: B. BRESLEND
BURKE VT5A SB 4
SHEET 66 OF 168