| | DIR | MILEPOINT | LOCATION CODE | MUTCD CODE | WIDTH | HEIGHT | SHEETING REMARKS | SIGN LEGEND | NEW SIGNS "A" | NEW SIGNS "B" | EXISTING SIGNS RETAIN | EXISTING SIGNS SALVAGE FROM | EXISTING SIGNS SALVAGE TO | EXISTING SIGNS REMOVE | EXIST POST RETAIN | EXIST POST REMOVE | NUMBER OF NEW POSTS | SQUARE STEEL (in) 1.75 (LB / FT) 1.88 | SQUARE STEEL (in) 2.00 (LB / FT) 2.42 | SQUARE STEEL (in) 2.50 (LB / FT) 3.35 | TUBULAR STEEL Ø (IN) FOUNDATION | TUBULAR STEEL Ø (IN) 3.00 (LB / FT) 7.60 | TUBULAR STEEL Ø (IN) 3.50 (LB / FT) 9.00 | TUBULAR STEEL Ø (IN) 4.00 (LB / FT) 10.80 | TUBULAR STEEL Ø (IN) 5.00 (LB / FT) 14.60 | SIGN FRAME REQUIRED | REMARKS | SIGN DETAIL: DETAIL IN SHSM | SIGN DETAIL: DETAIL ON SHEET NUMBER | SIGN DETAIL: DETAIL ON STD SHEET NUMBER |
|---|---|---|---|---|---|---|---|---|---|---|---|---|---|---|---|---|---|---|---|---|---|---|---|---|---|---|---|---|---|
| | **WESTMORE** | | | **VT5A** | **NB** | | | FYG-FLUORESCENT YELLOW-GREEN | | | | | | | | | | | | | | | | | | | "SHSM" - STANDARD HIGHWAY SIGNS AND MARKINGS | | | |
| 10/19/16 | NB | 6.293 | A | VD-701 | 6 | 8 | | BRIDGE 10 VT 5A | | | 1 | | | | 1 | | | | | | | | | | | | | | |
| 10/24/16 | NB | 6.448 | A | W1-4L | 30 | 30 | | LEFT REVERSE CURVE | | | | | | 1 | 1 | | | | | | | | | | | | | | |
| | | | A | W1-4L | 30 | 30 | | | 6.25 | | | | | | | | | | | | | | | | | | X | | |
| | NB | 6.474 | A | M2-1 | 21 | 15 | | JCT | | | | | | 1 | | 1 | | | | | | | | | | | | | |
| | | | A | VM1-5A | 24 | 24 | | ROUTE 16 | | | | | | 1 | | | | | | | | | | | | | | | |
| | | | A | M2-1 | 21 | 15 | | | 2.19 | | | | | | | | 1 | | 12'-3" X | | | | | | | BLACK ON WHITE | X | | |
| | | | A | VM1-5A | 24 | 24 | | | 4.00 | | | | | | | | | | | | | | | | | | | | E-136C |
| 10/19/16 | NB | 6.520 | A | VW-060 | 30 | 30 | | HIDDEN DRIVES | | | | | | 1 | | 1 | | | | | | | | | | | | | |
| | | | A | VW-060 | 30 | 30 | | | 6.25 | | | | | | | | 1 | | 14'-0" X | | | | | | | | | | T-81 |
| | NB | 6.583 | A | VD1-1A | 72 | 10 | | ^UP CHARLESTON 9 | | | | | | 1 | | 2 | | | | | | | | | | | | | |
| | | | A | VD1-1A | 72 | 10 | | <--- BARTON 7 | | | | | | 1 | | | | | | | | | | | | | | | |
| | | | A | VD1-1A | 72 | 12 | | | 6.00 | | | | | | | | 2 | | 12'-3" X 10'-0" | | | | | | | | | 8 | |
| | | | A | VD1-1A | 72 | 12 | | 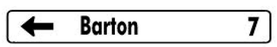 | 6.00 | | | | | | | | | | | | | | | | | | | 8 | |
| 10/20/16 | NB | 6.601 | A | M3-3 | 24 | 12 | | SOUTH | | | | | | 1 | | 1 | | | | | | | | | | | | | |
| | | | A | VM1-5A | 24 | 24 | | ROUTE 16 | | | | | | 1 | | | | | | | | | | | | | GREEN ON WHITE | | | |
| | | | | | | | | SHEET TOTALS | 30.69 | 0.00 | 1 | 0 | 0 | 8 | 2 | 5 | 4 | | 60 | | | | | | | | | |
| | | | | | | | | | SF | SF | EA | EA | EA | EA | EA | EA | EA | | FT | | | | | | | | | |
| | | | | | | | | TOWN TOTALS | 310.66 | 0.0 | 24.0 | 1.0 | 1.0 | 61.0 | 32.0 | 39.0 | 39 | | 585.0 | | | | | | | | | |

## SIGN SUMMARY SHEET

VERMONT AGENCY OF TRANSPORTATION

PROJECT NAME: **STATEWIDE- NORTHEAST**
PROJECT NUMBER: **STPG SIGN(56)**
FILE NAME: **z15T007VT5A-WESTMORE-NB**
PROJECT MANAGER: **B. BRESLEND**
DESIGNED BY: **O. DALMER**
PLOT DATE: **5/4/2016**
DRAWN BY: **O. DALMER**
CHECKED BY: **B. BRESLEND**
WESTMORE VT5A NB 8
SHEET **83** OF **168**