DIR	MILEPOINT	LOCATION CODE	MUTCD CODE	WIDTH	HEIGHT	SHEETING REMARKS	SIGN LEGEND	NEW SIGNS "A"	NEW SIGNS "B"	EXISTING SIGNS RETAIN	EXISTING SIGNS SALVAGE FROM	EXISTING SIGNS SALVAGE TO	EXISTING SIGNS REMOVE	EXIST POST RETAIN	EXIST POST REMOVE	NUMBER OF NEW POSTS	SQUARE STEEL (in) 1.75 (LB / FT) 1.88	SQUARE STEEL (in) 2.00 (LB / FT) 2.42	SQUARE STEEL (in) 2.50 (LB / FT) 3.35	FOUNDATION	TUBULAR STEEL Ø (IN) 3.00 (LB / FT) 7.60	TUBULAR STEEL Ø (IN) 3.50 (LB / FT) 9.00	TUBULAR STEEL Ø (IN) 4.00 (LB / FT) 10.80	TUBULAR STEEL Ø (IN) 5.00 (LB / FT) 14.60	SIGN FRAME REQUIRED	REMARKS	SIGN DETAIL: DETAIL IN SHSM	SIGN DETAIL: DETAIL ON SHEET NUMBER	SIGN DETAIL: DETAIL ON STD SHEET NUMBER
WESTMORE			**VT5A**	**NB**			FYG-FLUORESCENT YELLOW-GREEN																				"SHSM" - STANDARD HIGHWAY SIGNS AND MARKINGS			
		A	UNK.	12	24		NEK BYWAY			1																	SALVAGE SIGN ON NEW POST			
		A	M3-1	24	12			2.00																			GREEN ON WHITE	X		
		A	VM1-5	24	24			4.00																					E-136B
NB	6.742	A	VD2-1	72	10		W CHARLESTON 9						1	2															
		A	VD2-1	72	12		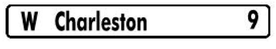	6.00																				8	
NB	6.776	A	R2-1	24	30		SPEED LIMIT 35						1		1														
		A	R2-1	24	30			5.00								1		15'-6" X									X		
NB	6.954	A	R2-1	24	30		SPEED LIMIT 45						1		1														
		A	R2-1	24	30			5.00								1		15'-3" X									X		
NB	7.160	A	VD3-1	60	12		PARENTEAU LN			1				1															
NB	7.221	A	R2-1	24	30		SPEED LIMIT 50						1		1														
		A	R2-1	24	30			5.00								1		13'-6" X									X		
SIGN SUMMARY SHEET							SHEET TOTALS	27.00	0.00	2	0	0	4	3	3	3		45										
								SF	SF	EA	EA	EA	EA	EA	EA	EA		FT										
VERMONT AGENCY OF TRANSPORTATION							TOWN TOTALS	310.66	0.0	24.0	1.0	1.0	61.0	32.0	39.0	39		585.0										

10/24/16

PROJECT NAME: **STATEWIDE- NORTHEAST**
PROJECT NUMBER: **STPG SIGN(56)**

FILE NAME: **z15T007VT5A-WESTMORE-NB** PLOT DATE: **5/4/2016**
PROJECT MANAGER: **B. BRESLEND** DRAWN BY: **O. DALMER**
DESIGNED BY: **O. DALMER** CHECKED BY: **B. BRESLEND**
WESTMORE VT5A NB 10 SHEET **85** OF **168**