DIR	MILEPOINT	LOCATION CODE	MUTCD CODE	WIDTH	HEIGHT	SHEETING REMARKS	SIGN LEGEND	NEW SIGNS "A"	NEW SIGNS "B"	EXISTING SIGNS RETAIN	EXISTING SIGNS SALVAGE FROM	EXISTING SIGNS SALVAGE TO	EXISTING SIGNS REMOVE	EXIST POST RETAIN	EXIST POST REMOVE	NUMBER OF NEW POSTS	SQUARE STEEL (in) 1.75 (LB / FT) 1.88	SQUARE STEEL (in) 2.00 (LB / FT) 2.42	SQUARE STEEL (in) 2.50 (LB / FT) 3.35	FOUNDATION	TUBULAR STEEL Ø (IN) 3.00 (LB / FT) 7.60	TUBULAR STEEL Ø (IN) 3.50 (LB / FT) 9.00	TUBULAR STEEL Ø (IN) 4.00 (LB / FT) 10.80	TUBULAR STEEL Ø (IN) 5.00 (LB / FT) 14.60	SIGN FRAME REQUIRED	REMARKS	SIGN DETAIL: DETAIL IN SHSM	SIGN DETAIL: DETAIL ON SHEET NUMBER	SIGN DETAIL: DETAIL ON STD SHEET NUMBER
WESTMORE			**VT5A**	**SB**			FYG-FLUORESCENT YELLOW-GREEN																			"SHSM" - STANDARD HIGHWAY SIGNS AND MARKINGS			
SB	1.564	F	R2-1	24	30		SPEED LIMIT 35						1		1													
		F	UNK.	24	18		MAY 15 TO SEPT 15						1															
		F	R2-1	24	30			5.00								1		13'-9" X								X		
		F	VR-147	24	18		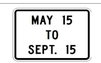	3.00																				15	
SB	1.414	F	R2-1	24	30		SPEED LIMIT 50						1		1													
		F	R2-1	24	30			5.00								1		14'-9" X								X		
SB	1.364	F	UNK.	18	24		NEK BYWAY			1				1														
SB	1.080	F	W11-2	30	30		PEDESTRIAN						1		1											SYMBOL		
		F	W11-2	30	30	FYG		6.25								1		15'-9" X								X		
		A	W16-4P	24	18	FYG		3.00																		X		
SB	0.951	F	VW-000	30	30		MOOSE CROSSING						1		1													
		F	VW-000	30	30			6.25								1		14'-9" X										T-80
SB	0.302	F	VD-018W	30	18		WESTMORE TRANSFER STATION				1		1		1													
SB	0.272	G	VD-018W	30	18		WESTMORE TRANSFER STATION					1				1		14'-0" X								REINSTALL SIGN ON NEW POST AT ENTRANCE TO TRANSFER STATION		
SB	0.012	F	VD3-1	72	12		WILLOUGHBY RIDGE RD	6.00		1 SIGN WAS MISSING				2												REQUIRES VEGETATION CLEARING		
							SHEET TOTALS	28.50	0.00	2	1	1	6	3	5	5		75										
								SF	SF	EA	EA	EA	EA	EA	EA	EA		FT										
							TOWN TOTALS	293.07	0.0	18.0	2.0	3.0	59.0	33.0	29.0	30		450.0										

10/19/16

11/14/16

SIGN SUMMARY SHEET

VERMONT AGENCY OF TRANSPORTATION

PROJECT NAME: **STATEWIDE- NORTHEAST**
PROJECT NUMBER: **STPG SIGN(56)**

FILE NAME: **z15T007VT5A-WESTMORE-SB** PLOT DATE: **5/4/2016**
PROJECT MANAGER: **B. BRESLEND** DRAWN BY: **O. DALMER**
DESIGNED BY: **O. DALMER** CHECKED BY: **B. BRESLEND**
WESTMORE VT5A SB 9 SHEET **94** OF **168**