DIR	MILEPOINT	LOCATION CODE	MUTCD CODE	WIDTH	HEIGHT	SHEETING REMARKS	SIGN LEGEND	NEW SIGNS "A"	NEW SIGNS "B"	EXISTING SIGNS RETAIN	EXISTING SIGNS SALVAGE FROM	EXISTING SIGNS SALVAGE TO	EXISTING SIGNS REMOVE	EXIST POST RETAIN	EXIST POST REMOVE	NUMBER OF NEW POSTS	SQUARE STEEL (in) 1.75 (LB / FT) 1.88	SQUARE STEEL (in) 2.00 (LB / FT) 2.42	SQUARE STEEL (in) 2.50 (LB / FT) 3.35	FOUNDATION	TUBULAR STEEL Ø (IN) 3.00 (LB / FT) 7.60	TUBULAR STEEL Ø (IN) 3.50 (LB / FT) 9.00	TUBULAR STEEL Ø (IN) 4.00 (LB / FT) 10.80	TUBULAR STEEL Ø (IN) 5.00 (LB / FT) 14.60	SIGN FRAME REQUIRED	REMARKS	SIGN DETAIL: DETAIL IN SHSM	SIGN DETAIL: DETAIL ON SHEET NUMBER	SIGN DETAIL: DETAIL ON STD SHEET NUMBER
BROWNINGTON				**VT5A**		**NB**	FYG-FLUORESCENT YELLOW-GREEN																			"SHSM" - STANDARD HIGHWAY SIGNS AND MARKINGS			
		A	M6-2L	21	15		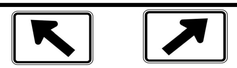	2.19																		GREEN ON WHITE	X		
		A	M3-4	24	12			2.00																			X		
		A	VM1-5	24	24			4.00																					E-136B
		A	M6-2R	21	15			2.19																			X		
NB	0.721	A	M3-1	24	12		NORTH						1	1															
		A	VM1-5	24	24		ROUTE 5A						1																
		C	UNK.	12	24		NEK (NORTHEST KINGDOM BYWAY)			1																			
		A	M3-1	24	12			2.00																		GREEN ON WHITE	X		
		A	VM1-5	24	24			4.00																					E-136B
NB	0.764	A	VD2-1	72	10		W CHARLESTON 8						1	2															
		A	VD2-1	72	10		DERBY CENTER 13						1																
		A	VD2-1	72	12			6.00																				8	
		A	VD2-1	72	12		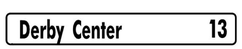	6.00																				8	
NB	0.840	A	R2-1	24	30		SPEED LIMIT 50						1	1															
		A	R2-1	24	30			5.00																			X		
							SHEET TOTALS	33.38	0.00	1	0	0	5	4	0	0		0											
								SF	SF	EA	EA	EA	EA	EA	EA	EA		FT											
							TOWN TOTALS	127.41	0.0	6.0	1.0	1.0	28.0	12.0	11.0	14		210.0											

10/27/16

SIGN SUMMARY SHEET

VERMONT AGENCY OF TRANSPORTATION

PROJECT NAME: **STATEWIDE- NORTHEAST**
PROJECT NUMBER: **STPG SIGN(56)**
FILE NAME: **z15T007VT5A-BROWNINGTON** PLOT DATE: **5/4/2016**
PROJECT MANAGER: **B. BRESLEND** DRAWN BY: **O. DALMER**
DESIGNED BY: **O. DALMER** CHECKED BY: **B. BRESLEND**
BROWNINGTON VT5A NB 3 SHEET **97** OF **168**