DIR	MILEPOINT	LOCATION CODE	MUTCD CODE	WIDTH	HEIGHT	SHEETING REMARKS	SIGN LEGEND	NEW SIGNS "A"	NEW SIGNS "B"	EXISTING SIGNS RETAIN	EXISTING SIGNS SALVAGE FROM	EXISTING SIGNS SALVAGE TO	EXISTING SIGNS REMOVE	EXIST POST RETAIN	EXIST POST REMOVE	NUMBER OF NEW POSTS	SQUARE STEEL (in) 1.75 (LB / FT) 1.88	SQUARE STEEL (in) 2.00 (LB / FT) 2.42	SQUARE STEEL (in) 2.50 (LB / FT) 3.35	FOUNDATION	TUBULAR STEEL Ø (IN) 3.00 (LB / FT) 7.60	TUBULAR STEEL Ø (IN) 3.50 (LB / FT) 9.00	TUBULAR STEEL Ø (IN) 4.00 (LB / FT) 10.80	TUBULAR STEEL Ø (IN) 5.00 (LB / FT) 14.60	SIGN FRAME REQUIRED	REMARKS	SIGN DETAIL: DETAIL IN SHSM	SIGN DETAIL: DETAIL ON SHEET NUMBER	SIGN DETAIL: DETAIL ON STD SHEET NUMBER
BURKE			**VT114**	**NB**			FYG-FLUORESCENT YELLOW-GREEN																				"SHSM" - STANDARD HIGHWAY SIGNS AND MARKINGS			
	0.000	C	VD-024	72	10		BURKE / LYNDON						1		1														
		C	VD-700	6	8		MM 1140, 0307, 0410						1																
		C	VD-700	6	8		MM 1140, 0302, 0000						~~1~~																
		C	VD-024	72	10		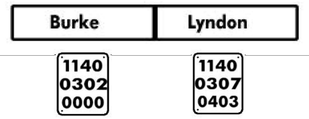	5.00								2	12'-0" X 12'-0"										T-94
		C	VD-700	6	10			0.42																				T-44
		C	VD-700	6	10			0.42																				T-44
NB	0.001	A	R2-1	24	30		SPEED LIMIT 40						1		1														
		A	R2-1	30	36			7.50								1	14'-3" X									X		
NB	0.108	A	VR2-5A	24	30		REDUCED SPEED AHEAD						1		1														
		A	W3-5	36	36			9.00								2	14'-6" X 14'-6"									X		
NB	0.150	A	VD-018	30	18		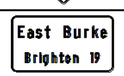	3.75								1	13'-0" X									INSTALL PROPOSED VILLAGE SIGN 222 FEET NORTH OF "REDUCED SPEED AHEAD" SIGN		6	
NB	0.193	A	VD-062AS	72	16		INN AT MOUNTAIN <--- VIEW FARM 1			1				2															
NB	0.231	A	R2-1	24	30		SPEED LIMIT 30						1		1														
		A	R2-1	30	36			7.50								1	15'-0" X									X		
NB	0.293	A	W1-10	30	30		MODIFIED RIGHT CURVE						1		1														
							SHEET TOTALS	33.59 SF	0.00 SF	1 EA	0 EA	0 EA	7 EA	2 EA	5 EA	7 EA	105 FT												
							TOWN TOTALS	264.34	0.0	12.0	2.0	2.0	47.0	17.0	34.0	47	705.0												

10/31/16

SIGN SUMMARY SHEET

VERMONT AGENCY OF TRANSPORTATION

PROJECT NAME: **STATEWIDE- NORTHEAST**
PROJECT NUMBER: **STPG SIGN(56)**
FILE NAME: **z15T007VT114-BURKE-NB.xls**
PROJECT MANAGER: **B. BRESLEND**
DESIGNED BY: **O. DALMER**
PLOT DATE: **5/4/2016**
DRAWN BY: **O. DALMER**
CHECKED BY: **B. BRESLEND**
BURKE VT114 NB 1
SHEET **130** OF **168**