	DIR	MILEPOINT	LOCATION CODE	MUTCD CODE	WIDTH	HEIGHT	SHEETING REMARKS	SIGN LEGEND	NEW SIGNS "A"	NEW SIGNS "B"	EXISTING SIGNS RETAIN	EXISTING SIGNS SALVAGE FROM	EXISTING SIGNS SALVAGE TO	EXISTING SIGNS REMOVE	EXIST POST RETAIN	EXIST POST REMOVE	NUMBER OF NEW POSTS	SQUARE STEEL (in) 1.75 (LB / FT) 1.88	SQUARE STEEL (in) 2.00 (LB / FT) 2.42	SQUARE STEEL (in) 2.50 (LB / FT) 3.35	FOUNDATION	TUBULAR STEEL Ø (IN) 3.00 (LB / FT) 7.60	TUBULAR STEEL Ø (IN) 3.50 (LB / FT) 9.00	TUBULAR STEEL Ø (IN) 4.00 (LB / FT) 10.80	TUBULAR STEEL Ø (IN) 5.00 (LB / FT) 14.60	SIGN FRAME REQUIRED	REMARKS	SIGN DETAIL: DETAIL IN SHSM	SIGN DETAIL: DETAIL ON SHEET NUMBER	SIGN DETAIL: DETAIL ON STD SHEET NUMBER
	BURKE			**VT114**	**SB**			FYG-FLUORESCENT YELLOW-GREEN																			"SHSM" - STANDARD HIGHWAY SIGNS AND MARKINGS			
			F	VM1-5	30	24			5.00																				E-136B
	SB	4.306	F	W5-2	30	30		NARROW BRIDGE						1		1													
			F	W5-2	30	30			6.25								1		15'-0" X								X		
11/8/16	SB	4.149	F	VD-701	6	8		BRIDGE 16 VT 114			1				1														
	SB	4.149	F	OM3-R	12	36		RIGHT OBJECT MARKER						1		1													
			F	OM3-R	12	36			3.00								1		11'-0" X								X		
11/9/16	SB	4.143	E	OM3-L	12	36		LEFT OBJECT MARKER						1		1													
			E	OM3-L	12	36			3.00								1		11'-0" X								X		
	SB	3.855	F	VD1-1A	54	7.5		<--- GULLUP MILLS 8						1		2													
			F	VD1-1A	54	7.5		<--- GRANBY 10						1															
			F	VD1-1A	72	12			6.00								2		13'-6" X 14'-6"									12	
11/8/16			F	VD1-1A	72	12		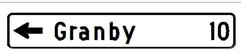	6.00																			12	
	SB	3.699	F	VD-701	6	8		BRIDGE 15 VT 114			1				1														
	SB	3.626	F	VW-000	30	30		MOOSE CROSSING						1		1													
			F	W7-3aP	24	18		NEXT 3 MILES						1															
	SIGN SUMMARY SHEET							SHEET TOTALS	29.25 SF	0.00 SF	2 EA	0 EA	0 EA	7 EA	2 EA	6 EA	5 EA	75 FT									
	VERMONT AGENCY OF TRANSPORTATION							TOWN TOTALS	266.00	0.0	8.0	1.0	1.0	50.0	10.0	42.0	51	765.0									

PROJECT NAME: **STATEWIDE- NORTHEAST**
PROJECT NUMBER: **STPG SIGN(56)**
FILE NAME: **z15T007VT114-BURKE-SB.xls** PLOT DATE: **5/4/2016**
PROJECT MANAGER: **B. BRESLEND** DRAWN BY: **O. DALMER**
DESIGNED BY: **O. DALMER** CHECKED BY: **B. BRESLEND**
BURKE VT114 SB 2 SHEET **138** OF **168**