DIR	MILEPOINT	LOCATION CODE	MUTCD CODE	WIDTH	HEIGHT	SHEETING REMARKS	SIGN LEGEND	NEW SIGNS "A"	NEW SIGNS "B"	EXISTING SIGNS RETAIN	EXISTING SIGNS SALVAGE FROM	EXISTING SIGNS SALVAGE TO	EXISTING SIGNS REMOVE	EXIST POST RETAIN	EXIST POST REMOVE	NUMBER OF NEW POSTS	SQUARE STEEL (in) 1.75 (LB / FT) 1.88	SQUARE STEEL (in) 2.00 (LB / FT) 2.42	SQUARE STEEL (in) 2.50 (LB / FT) 3.35	FOUNDATION	TUBULAR STEEL Ø (IN) 3.00 (LB / FT) 7.60	TUBULAR STEEL Ø (IN) 3.50 (LB / FT) 9.00	TUBULAR STEEL Ø (IN) 4.00 (LB / FT) 10.80	TUBULAR STEEL Ø (IN) 5.00 (LB / FT) 14.60	SIGN FRAME REQUIRED	REMARKS	SIGN DETAIL: DETAIL IN SHSM	SIGN DETAIL: DETAIL ON SHEET NUMBER	SIGN DETAIL: DETAIL ON STD SHEET NUMBER
BRIGHTON			**VT114**		**NB**		FYG-FLUORESCENT YELLOW-GREEN																			"SHSM" - STANDARD HIGHWAY SIGNS AND MARKINGS			
		A	VM1-5	30	24		ROUTE 105						1															
		A	M6-1L	21	15		<--- LEFT						1															
		A	M3-1	24	12		NORTH						1															
		A	VM1-5	30	24		ROUTE 114						1															
		A	M6-1R	21	15		RIGHT ---->						1															
		A	M3-2	24	12		EAST						1															
		A	VM1-5	30	24		ROUTE 105						1															
11/15/16		A	M6-1R	21	15		RIGHT ---->						1															
		A	VD-700	6	10		MM 1050, 0504, 0220						~~1~~															
		A	M3-4	24	12		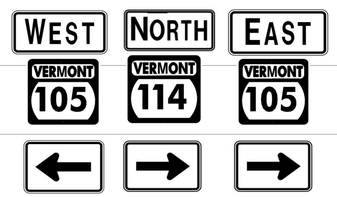	2.00														3D	GREEN ON WHITE	X		
		A	VM1-5	30	24			5.00																				X		
		A	M6-1L	21	15			2.19																			GREEN ON WHITE			E-136B
		A	M3-1	24	12			2.00																			GREEN ON WHITE	X		
		A	VM1-5	30	24			5.00																						E-136B
		A	M6-1R	21	15			2.19																			GREEN ON WHITE	X		
							SHEET TOTALS	18.38	0.00	0	0	0	9	0	0	0	0												
								SF	SF	EA	EA	EA	EA	EA	EA	EA	FT												
							TOWN TOTALS	199.02	0.0	3.0	0.0	0.0	46.0	13.0	17.0	25	375.0												

SIGN SUMMARY SHEET

VERMONT AGENCY OF TRANSPORTATION

PROJECT NAME: **STATEWIDE- NORTHEAST**
PROJECT NUMBER: **STPG SIGN(56)**

FILE NAME: **z15T007VT114-BRIGHTON-NB.**; PLOT DATE: **5/4/2016**
PROJECT MANAGER: **B. BRESLEND** DRAWN BY: **O. DALMER**
DESIGNED BY: **O. DALMER** CHECKED BY: **B. BRESLEND**
BRIGHTON VT114 NB 6 SHEET **160** OF **168**