INDEX OF SHEETS

1	TITLE SHEET
2	QUANTITY SHEET
3	TRAFFIC CONTROL PLAN
4	MISCELLANEOUS DETAILS SHEET
5-10	ROAD QUANTITY SHEETS 1-6
11	ROAD SUMMARY SHEET

STANDARDS LIST

E-192	10/12/2000
E-193	8/18/1995
T-1	8/6/2012
T-11	8/6/2012
T-12	8/6/2012
T-22	8/6/2012
T-23	8/6/2012
T-24	8/6/2012
T-28	8/6/2012
T-29	8/6/2012
T-31	8/6/2012

STATE OF VERMONT
AGENCY OF TRANSPORTATION

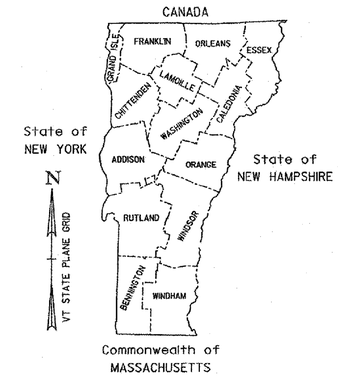

PROPOSED IMPROVEMENT
STATEWIDE - SOUTH REGION
NATIONAL HIGHWAY SYSTEM, STATE ROAD AND CLASS 1 TOWN HIGHWAYS

APPLICATION OF CENTER LINE, EDGE LINE AND LANE LINE MARKINGS ON NATIONAL HIGHWAY AND STATE SYSTEM ROADS AND CENTER LINE MARKINGS ON CLASS 1 TOWN HIGHWAYS WITHIN ADDISON, BENNINGTON, RUTLAND, WINDHAM, AND WINDSOR COUNTIES.

LENGTH OF PROJECT 1098.914 MI = 5,802,265.92 LF

RECORD PLANS

CONTRACTOR: L&D SAFETY MARKINGS CORP.-BERLIN, VT

RESIDENT ENGINEER: TOM CHASE

CONSTRUCTION BEGAN: JUNE 15, 2016

CONSTRUCTION COMPLETE: OCTOBER 11, 2016

RECORD PLANS BY: TOM CHASE & JESSE IVES

I HEREBY CERTIFY THAT ALL THE CONSTRUCTION REQUIRED BY THIS SET OF DRAWINGS HAS BEEN ACCOMPLISHED AS INDICATED HEREIN.

BY Thomas A. Chase RESIDENT ENGINEER

DATE October 17, 2017

NOTE: Any further information concerning final quantities, amounts or other details relative to this project may be found at Central Files in the electronic archives.

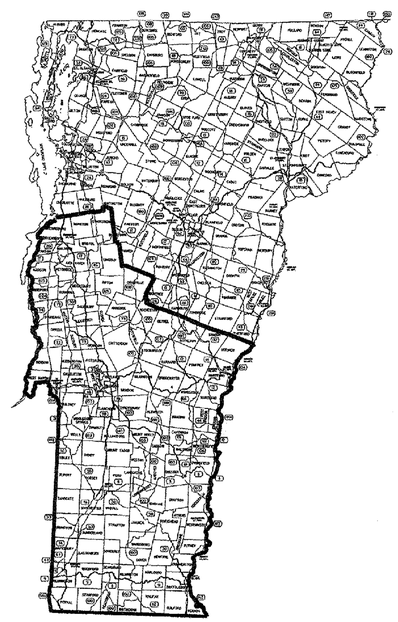

BUILT AS DESIGNED

CONSTRUCTION IS TO BE CARRIED ON IN ACCORDANCE WITH THESE PLANS AND THE STANDARD SPECIFICATIONS FOR CONSTRUCTION DATED 2011, AS APPROVED BY THE FEDERAL HIGHWAY ADMINISTRATION ON JULY 20, 2011 FOR USE ON THIS PROJECT, INCLUDING ALL SUBSEQUENT REVISIONS AND SUCH REVISED SPECIFICATIONS AND SPECIAL PROVISIONS AS ARE INCORPORATED IN THESE PLANS.

QUALITY ASSURANCE PROGRAM : LEVEL 1

SURVEYED BY : N/A
SURVEYED DATE : N/A

DATUM
VERTICAL N/A
HORIZONTAL N/A

DIRECTOR OF PROJECT DELIVERY
APPROVED [signature] DATE 2/22/2016

PROJECT MANAGER : PATRICIA COBURN P.E.

PROJECT NAME : STATEWIDE - SOUTH REGION
PROJECT NUMBER : STPG MARK(305)

SHEET 1 OF 11 SHEETS