TEMPORARY 4 INCH WHITE LINE, PAINT
SPECIAL PROVISION (DURABLE 4 INCH WHITE LINE, POLYUREA)(28 MILS)
(ALL LINES WILL INCLUDE EDGE LINE BREAKS AND
RADIUS FOR TOWN HIGHWAYS)
NEW HAVEN:
STA. 51+00.0 - STA. 67+00.0 LT & RT

TEMPORARY 4 INCH YELLOW LINE, PAINT
SPECIAL PROVISION (DURABLE 4 INCH YELLOW LINE, POLYUREA)(28 MILS)
(ALL LINES WILL INCLUDE C/L BREAKS FOR
TOWN HIGHWAYS) S=SOLID, D=DASHED

NEW HAVEN:	LT	℄	RT
STA. 51+00.0 - STA. 54+00.0	D	-	S
STA. 54+00.0 - STA. 65+00.0	S	-	S
STA. 65+00.0 - STA. 67+00.0	S	-	D

MILLED RUMBLE STRIPS (CENTERLINE)
NEW HAVEN:
STA. 51+00.00 - STA. ~~67+00.00~~ 56+00
STA 59+55 - STA 67+00

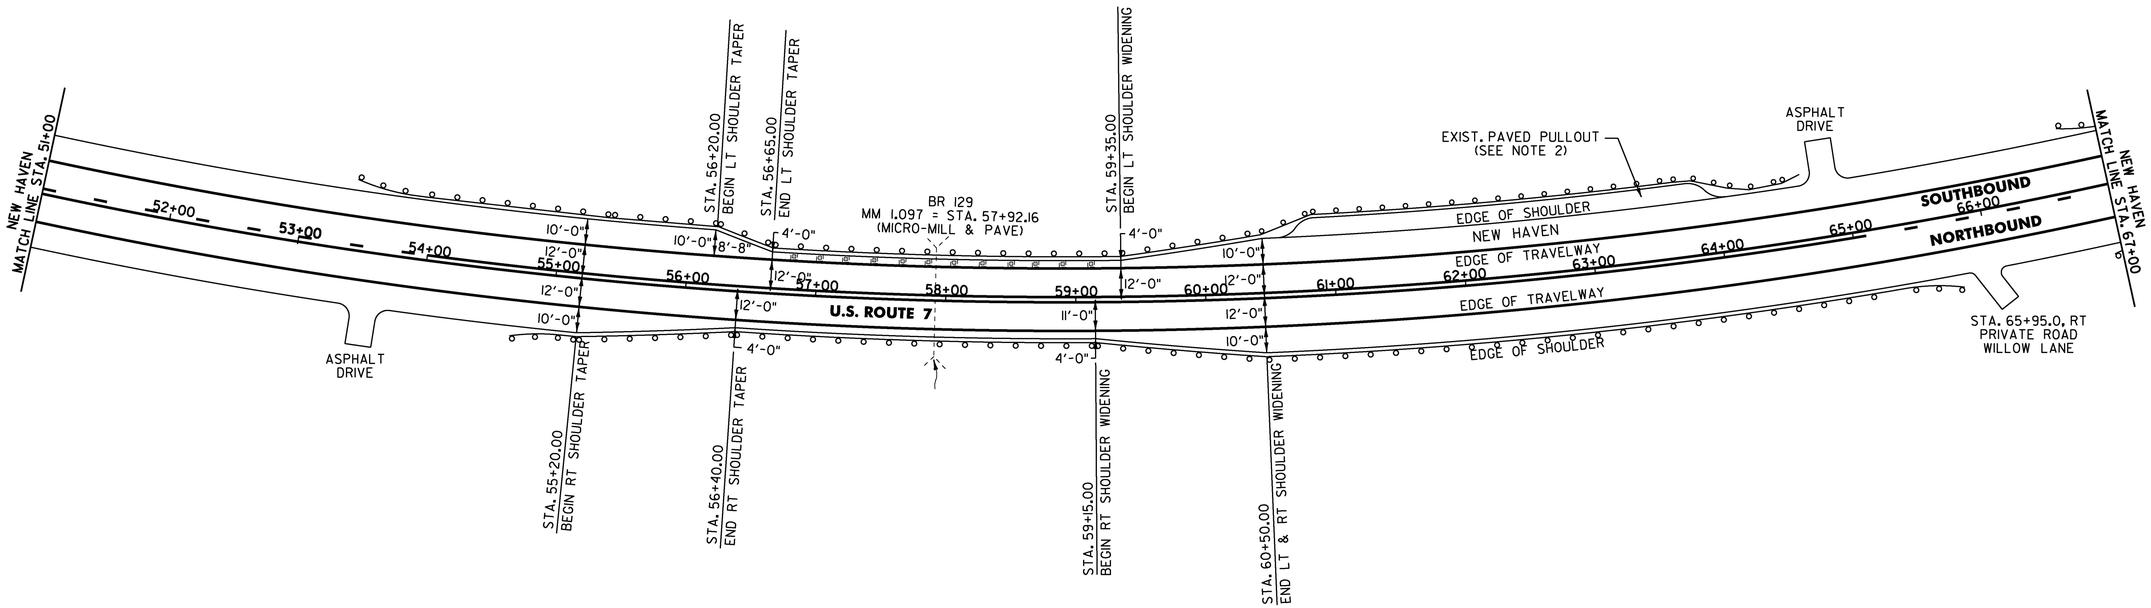

NOTES:

1. THERE ARE 12 EXISTING DRAINAGE STRUCTURES LOCATED IN THE SOUTHBOUND SHOULDER ON BR 129. HEIGHT ADJUSTMENTS OR REHABILITATIONS WILL NOT BE REQUIRED.

2. PAVE FULL WIDTH OF PULLOUT.

NOT TO SCALE

PROJECT NAME:	MIDDLEBURY-FERRISBURGH
PROJECT NUMBER:	NH SURF(55)

FILE NAME: pl5v015.dgn	PLOT DATE: 16-MAR-2016
PROJECT LEADER: J. HARRINGTON	DRAWN BY: L. BULLOCK
DESIGNED BY: L. BULLOCK	CHECKED BY: J. HARRINGTON
PLAN SHEET 11	SHEET 25 OF 96