TEMPORARY 4 INCH WHITE LINE, PAINT
SPECIAL PROVISION (DURABLE 4 INCH WHITE LINE, POLYUREA)(28 MILS)
(ALL LINES WILL INCLUDE EDGE LINE BREAKS AND
RADIUS FOR TOWN HIGHWAYS)
NEW HAVEN:
STA. 163+00.0 - STA. 179+00.0 LT & RT

TEMPORARY 4 INCH YELLOW LINE, PAINT
SPECIAL PROVISION (DURABLE 4 INCH YELLOW LINE, POLYUREA)(28 MILS)
(ALL LINES WILL INCLUDE C/L BREAKS FOR
TOWN HIGHWAYS) S=SOLID, D=DASHED

NEW HAVEN:	LT	℄	RT
STA. 163+00.0 - STA. 168+50.0	S	-	D
STA. 168+50.0 - STA. 174+50.0	-	D	-
STA. 174+50.0 - STA. 179+00.0	D	-	S

~~MILLED RUMBLE STRIPS (CENTERLINE)~~
~~NEW HAVEN:~~
~~STA. 163+00.00 - STA. 165+26.00~~

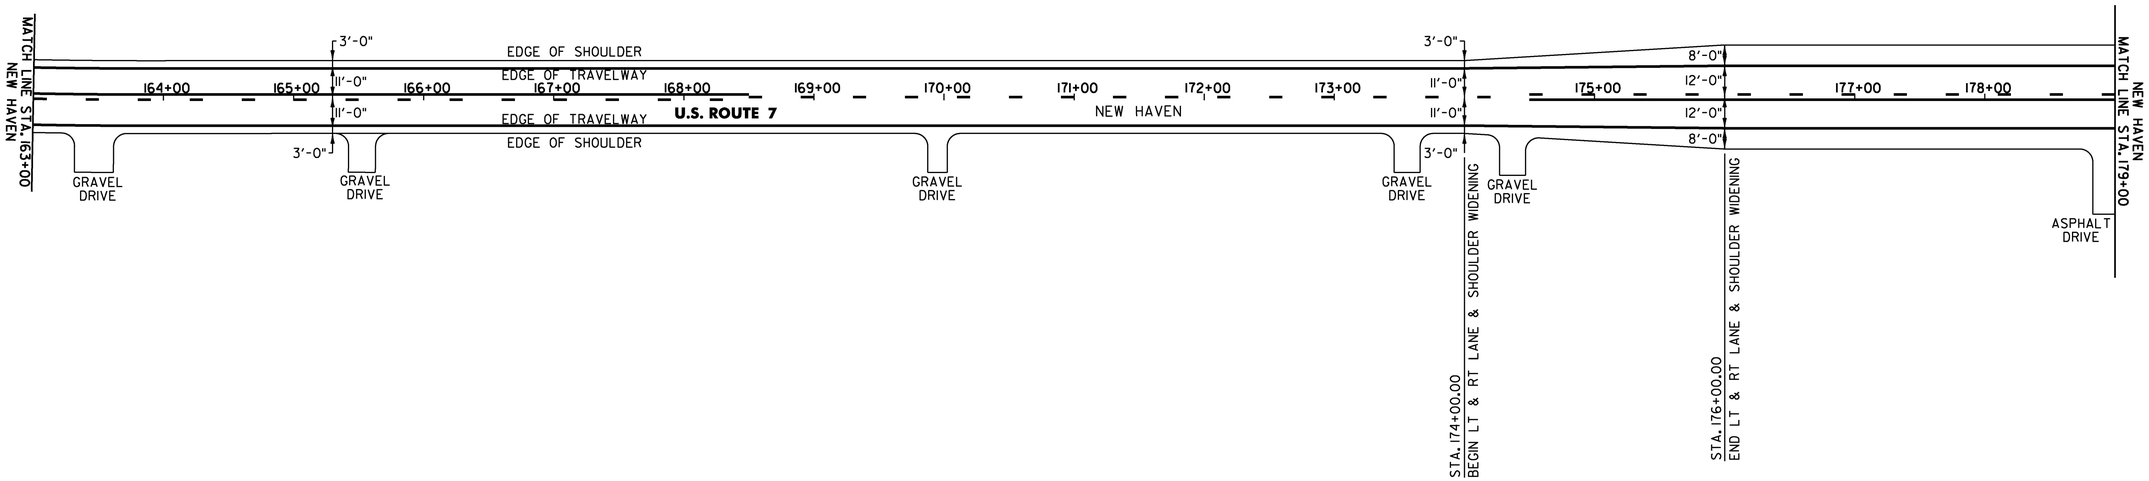

NOT TO SCALE

PROJECT NAME:	MIDDLEBURY-FERRISBURGH
PROJECT NUMBER:	NH SURF(55)

FILE NAME: pl5v015.dgn	PLOT DATE: 16-MAR-2016
PROJECT LEADER: J. HARRINGTON	DRAWN BY: L. BULLOCK
DESIGNED BY: L. BULLOCK	CHECKED BY: J. HARRINGTON
PLAN SHEET 18	SHEET 32 OF 96