TEMPORARY 4 INCH WHITE LINE, PAINT
SPECIAL PROVISION (DURABLE 4 INCH WHITE LINE, POLYUREA)(28 MILS)

(ALL LINES WILL INCLUDE EDGE LINE BREAKS AND RADIUS FOR TOWN HIGHWAYS)

NEW HAVEN:
STA. 179+00.0 - STA. 195+00.0 LT & RT

TEMPORARY LETTER OR SYMBOL, PAINT
SPECIAL PROVISION (DURABLE LETTER OR SYMBOL, POLYUREA)(28 MILS) OR
DURABLE LETTER OR SYMBOL, THERMOPLASTIC

NEW HAVEN:
STA. 191+49.0 LT, ARROW
STA. 193+29.0 LT, ARROW

TEMPORARY 4 INCH YELLOW LINE, PAINT
SPECIAL PROVISION (DURABLE 4 INCH YELLOW LINE, POLYUREA)(28 MILS)

(ALL LINES WILL INCLUDE C/L BREAKS FOR TOWN HIGHWAYS) S=SOLID, D=DASHED

NEW HAVEN:	LT	℄	RT
STA. 179+00.0 - STA. 182+50.0	D	-	S
STA. 182+50.0 - STA. 195+00.0	S	-	S

MILLED RUMBLE STRIPS (CENTERLINE)

NEW HAVEN:
179+00 STA. ~~182+69.00~~ - STA. ~~190+61.00~~ 191+50
194+45 STA. ~~193+78.00~~ - STA. 195+00.00

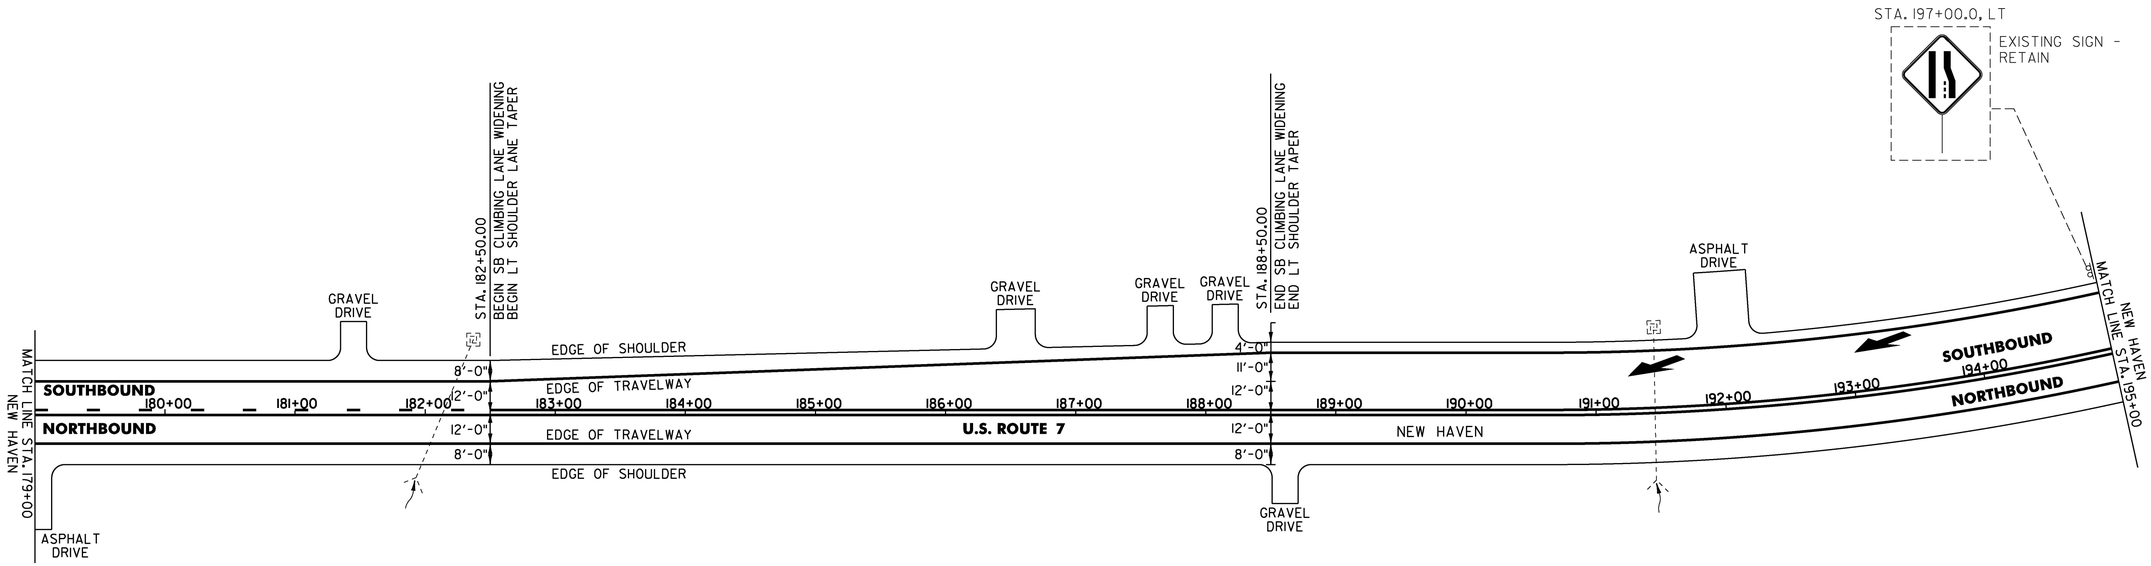

NOT TO SCALE

PROJECT NAME: MIDDLEBURY-FERRISBURGH	
PROJECT NUMBER: NH SURF(55)	
FILE NAME: p15v015.dgn	PLOT DATE: 16-MAR-2016
PROJECT LEADER: J. HARRINGTON	DRAWN BY: L. BULLOCK
DESIGNED BY: L. BULLOCK	CHECKED BY: J. HARRINGTON
PLAN SHEET 19	SHEET 33 OF 96