TEMPORARY 4 INCH WHITE LINE, PAINT
SPECIAL PROVISION (DURABLE 4 INCH WHITE LINE, POLYUREA)(28 MILS)
(ALL LINES WILL INCLUDE EDGE LINE BREAKS AND
RADIUS FOR TOWN HIGHWAYS)
NEW HAVEN:
STA. 275+00.0 - STA. ~~287+47.0 LT~~ 287+68 LT
STA. 275+00.0 - STA. 288+53.0 RT
STA. 288+12.0 - STA. 291+00.0 LT
STA. 289+18.0 - STA. 291+00.0 RT
STA. 282+35.0 - STA. 284+70.0 SOLID LT
STA. 284+70.0 - STA. 286+50.0 DOTTED LT & RT
STA. 286+50.0 - STA. 287+79.0 SOLID RT

TEMPORARY 4 INCH YELLOW LINE, PAINT
SPECIAL PROVISION (DURABLE 4 INCH YELLOW LINE, POLYUREA)(28 MILS)
(ALL LINES WILL INCLUDE C/L BREAKS FOR
TOWN HIGHWAYS) S=SOLID, D=DASHED
NEW HAVEN:
STA. 275+00.0 - STA. 278+50.0 DOUBLE SOLID C/L
STA. 278+50.0 - STA. 281+75.0 DOUBLE SOLID MEDIAN LT/RT
STA. 282+55.0 - STA. 287+81.0 DOUBLE SOLID MEDIAN LT/RT
STA. 289+00.0 - STA. 291+00.0 DOUBLE SOLID MEDIAN LT/RT

TEMPORARY 8 INCH YELLOW LINE, PAINT
SPECIAL PROVISION (DURABLE 8 INCH YELLOW LINE, POLYUREA)(28 MILS)
NEW HAVEN:
STA. 278+50.0 - STA. 281+75.0 HATCHED MEDIAN C/L
STA. 282+55.0 - STA. 287+81.0 HATCHED MEDIAN LT/RT
STA. 289+00.0 - STA. 291+00.0 HATCHED MEDIAN C/L

TEMPORARY 24 INCH STOP BAR, PAINT
SPECIAL PROVISION (DURABLE 24 INCH STOP BAR, POLYUREA)(28 MILS) OR
DURABLE 24 INCH STOP BAR, THERMOPLASTIC
NEW HAVEN:
STA. 282+32.16 RT, VT. ROUTE 17
STA. 288+71.04 LT, VT. ROUTE 17

SPECIAL PROVISION (DURABLE LETTER OR SYMBOL, POLYUREA)(28 MILS) OR
DURABLE LETTER OR SYMBOL, THERMOPLASTIC
NEW HAVEN:

STA. 282+32.16 RT, VT. ROUTE 17, "STOP"	(4 EA)
STA. 282+61.3 LT/RT, ARROW	(1 EA)
STA. 283+16.0 LT/RT, "ONLY"	(4 EA)
STA. 283+66.0 LT/RT, ARROW	(1 EA)
STA. 284+16.0 LT/RT, "ONLY"	(4 EA)
STA. 284+66.0 LT/RT, ARROW	(4 EA)
STA. 286+54.3 LT/RT, ARROW	(1 EA)
STA. 287+10.0 LT/RT, "ONLY"	(4 EA)
STA. 287+70.7 LT/RT, ARROW	(1 EA)
STA. 288+71.04 LT, VT. ROUTE 17, "STOP"	(4 EA)

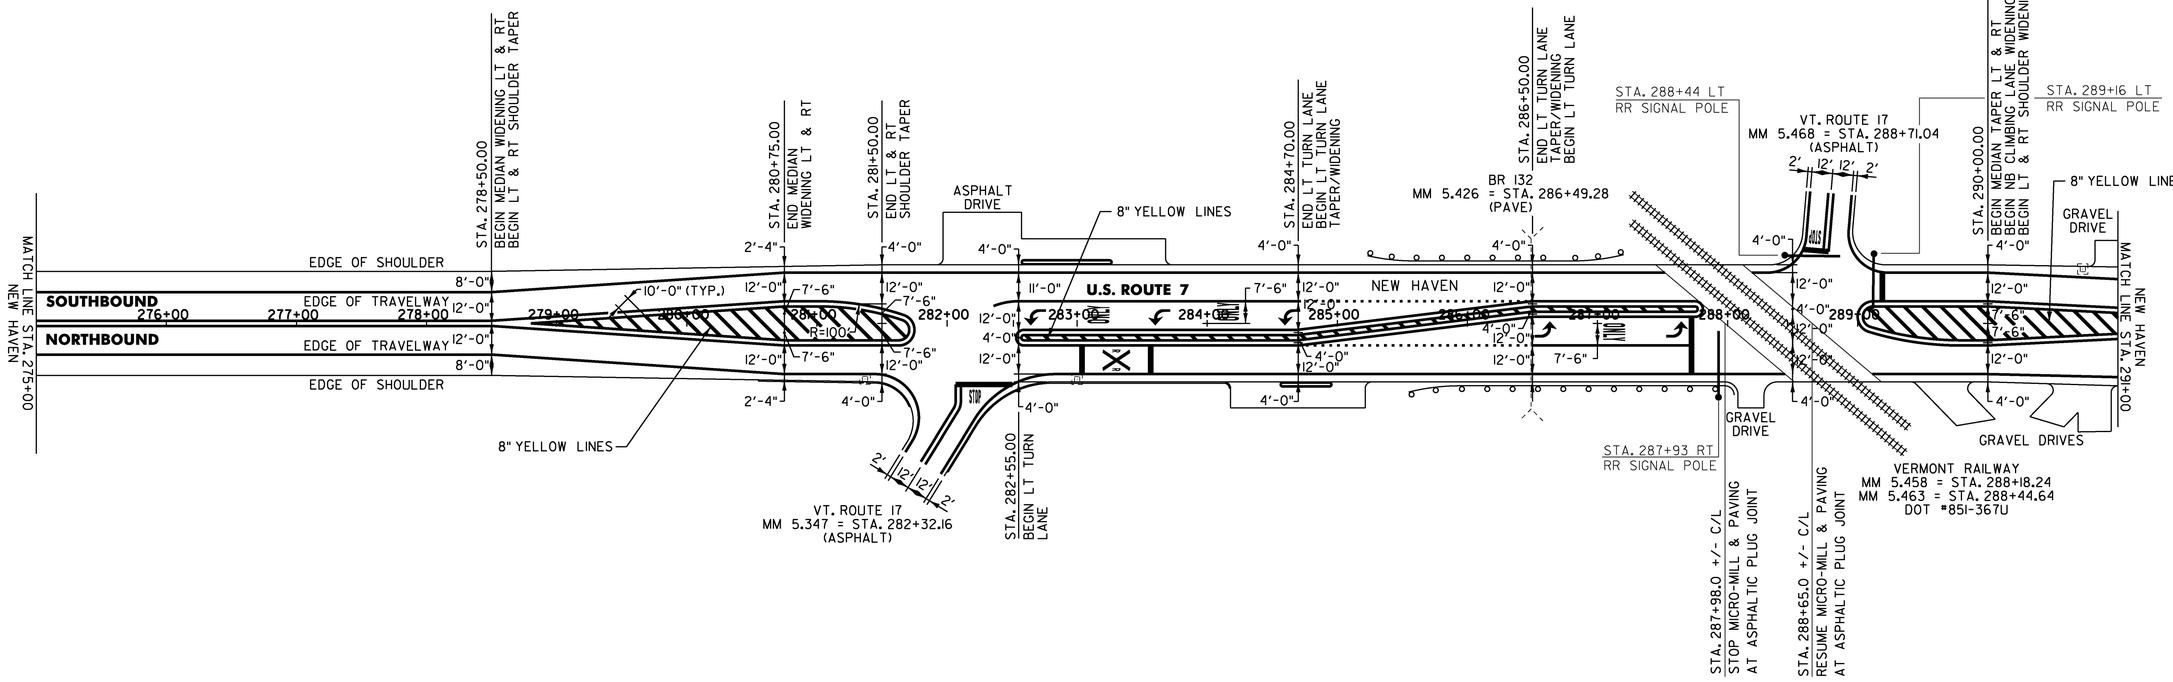

TEMPORARY LETTER OR SYMBOL, PAINT
NEW HAVEN:

STA. 282+32.16 RT, VT. ROUTE 17, "STOP"	(4 EA)
STA. 282+61.3 LT/RT, ARROW	(1 EA)
STA. 283+97.6 LT/RT, ARROW	(1 EA)
STA. 286+54.3 LT/RT, ARROW	(1 EA)
STA. 287+70.7 LT/RT, ARROW	(1 EA)
STA. 288+71.04 LT, VT. ROUTE 17, "STOP"	(4 EA)

CHANGING ELEV. OF DROP INLETS, CATCH BASINS, OR MANHOLES
NEW HAVEN:
STA. 281+37.0 RT (DID NOT ADJUST)
STA. 283+00.0 RT (DID NOT ADJUST)
STA. 290+73.0 LT (DID NOT ADJUST)

NOTE:
1. FOR RAILROAD PAVEMENT MARKING LAYOUT, SEE SIGNING AND STRIPING, PLAN A.

NOT TO SCALE

PROJECT NAME:	MIDDLEBURY-FERRISBURGH
PROJECT NUMBER:	NH SURF(55)

FILE NAME: pl5v015.dgn	PLOT DATE: 16-MAR-2016
PROJECT LEADER: J. HARRINGTON	DRAWN BY: L. BULLOCK
DESIGNED BY: L. BULLOCK	CHECKED BY: J. HARRINGTON
PLAN SHEET 25	SHEET 39 OF 96