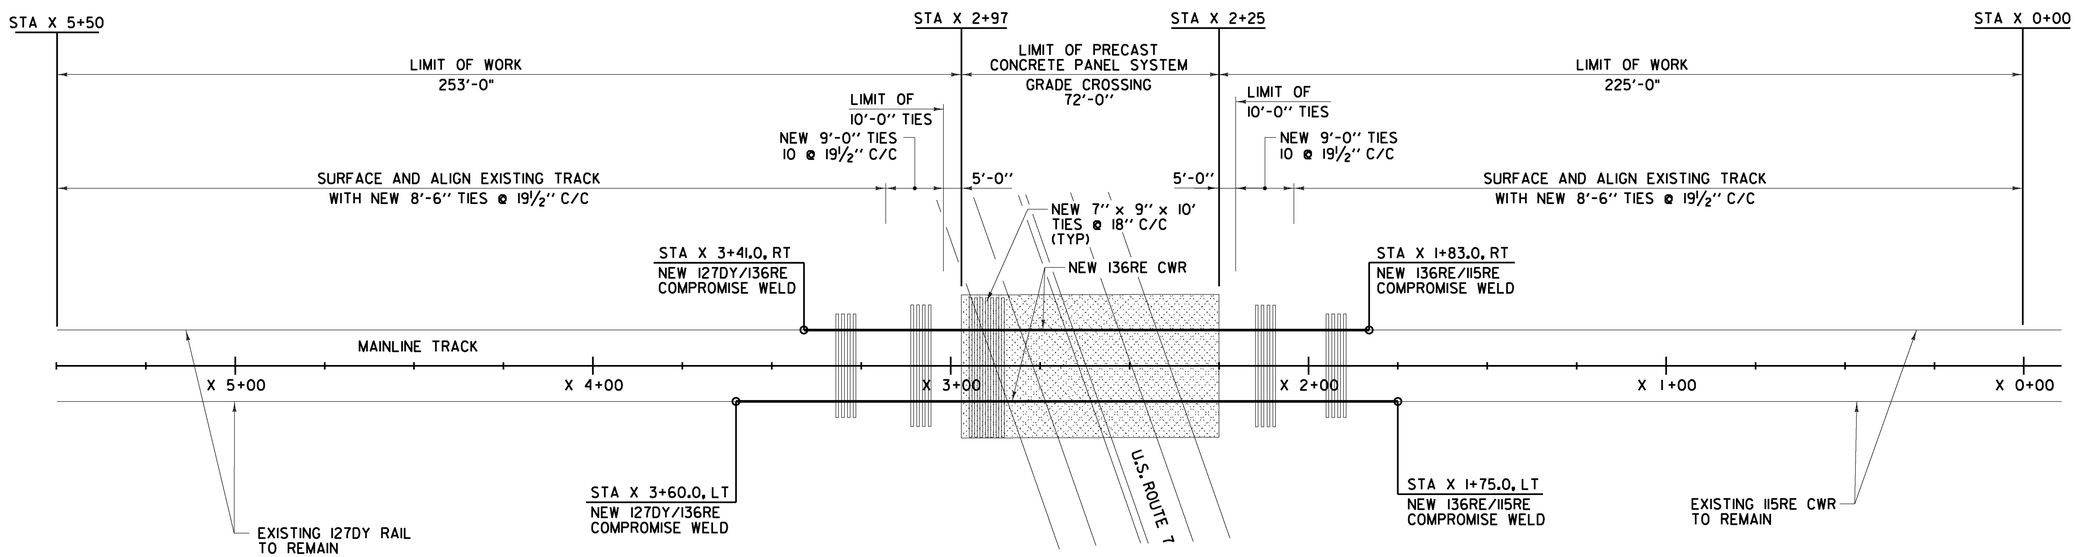

SCHEMATIC PLAN VIEW
TOWN OF FERRISBURGH
U.S. ROUTE 7
MM 0.81
AARDOT 851-375L
VERMONT RAILWAY
NORTHERN SUBDIVISION
MP 100.04
HIGHWAY CROSSING

NOT TO SCALE

PROJECT NAME: MIDDLEBURY - FERRISBURGH	
PROJECT NUMBER: NH SURF (55)	
FILE NAME: z15v015rrspv.dgn	PLOT DATE: 3/29/2016
PROJECT LEADER: D.E.G.	DRAWN BY: C.A.K.
DESIGNED BY: M.J.M.	CHECKED BY: D.W.E.
SCHEMATIC PLAN VIEW A	SHEET 85 OF 96

CHA

FILE NAME = V:\Projects\ANY\K4\30674\CADD_MSTN\15v015\Consultants\Rail\z15v015rrspv.dgn
DATE/TIME = 3/29/2016
USER = 1454