POST COMPLETE

|P|O|S|T| |T|E|R|M| | | | | | | | | |

FOR USE WITH PLUGBOARDS 59686-000-00 AND 59686-000-01

42788-001-02

FOR ASSEMBLY, SEE: 42788-001-00

Super | 42788-1 GR. 2 (14 x 20) REV. B DTD. 4-2-92 | Sheet 1 Of 1

ITEM	REQ'D	DRAWING NO.	REF.	NAME	REV
1	1	00376-009-00	1	Screw, .242-24 x 2.39 Lg	D
2	1	42839-005-00	4	Nut, .242-24 x .19 Thk Hex	
3	6	01225-002-00	5	Washer, .266 ID, .188 OD, .04 Thk	
4	4	42843-001-00	6	Nut, .242-24 x .31 Thk Hex	
5	1	59825-052-00	8	Terminal, .242 Ring (20-16)	
6	1	53148-000-00		Bag	

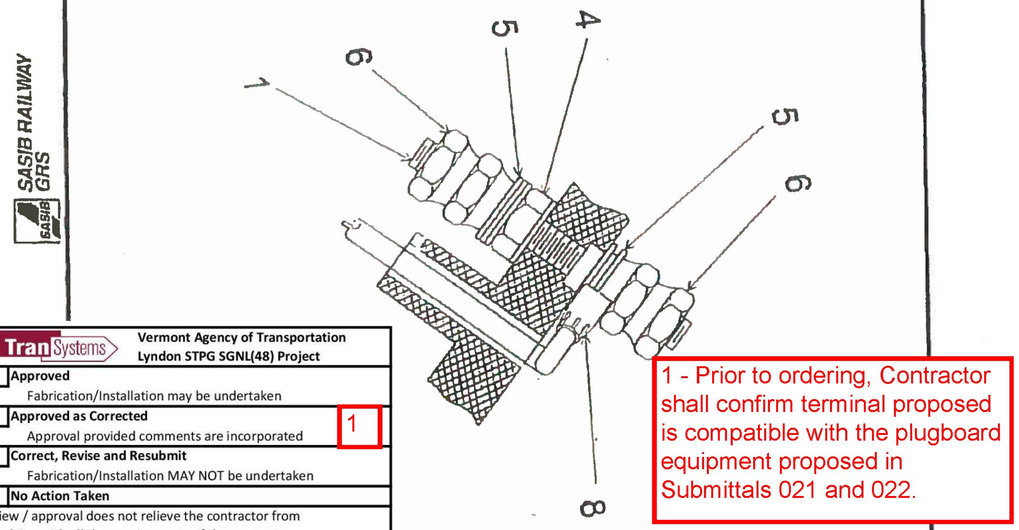

SASIB RAILWAY GRS

TranSystems — Vermont Agency of Transportation, Lyndon STPG SGNL(48) Project

- [ ] Approved — Fabrication/Installation may be undertaken
- [X] Approved as Corrected — Approval provided comments are incorporated — 1
- [ ] Correct, Revise and Resubmit — Fabrication/Installation MAY NOT be undertaken
- [ ] No Action Taken

Review / approval does not relieve the contractor from complying with all the requirements of the contract

1 - Prior to ordering, Contractor shall confirm terminal proposed is compatible with the plugboard equipment proposed in Submittals 021 and 022.

Notice Of Confidential Information: Information contained herein is confidential and is the property of the General Railway Signal Company. Where furnished with a proposal, the recipient shall use it solely to evaluate the proposal. Where furnished to a customer, it shall be used solely for purposes of inspection, installation or maintenance. Where furnished to a supplier, it shall be used solely in the performance of the contract. The information shall not be used or disclosed by the recipient for any other purpose whatsoever.

FOR OFFICE USE ONLY

REV	C	D					
DATE	5-4-92	6-3-93					
R NO.	A50879	A52496					
APP'D	JTF/RWD/NJI	MJB/RWD/WDR					

(H1067)