DIRECTION	MILEPOINT	LOCATION CODE (SHEET 4)	SIGN CODE	WIDTH (IN)	HEIGHT (IN)	SHEETING REMARKS	SIGN LEGEND	NEW SIGNS "A"	NEW SIGNS "B"	EXISTING SIGNS RETAIN	EXISTING SIGNS SALVAGE FROM	EXISTING SIGNS SALVAGE TO	EXISTING SIGNS REMOVE	EXIST POST RETAIN	EXIST POST REMOVE	NUMBER OF NEW POSTS	SQUARE STEEL (IN) 1.75 (LB / FT) 1.88	SQUARE STEEL (IN) 2.00 (LB / FT) 2.42	SQUARE STEEL (IN) 2.50 (LB / FT) 3.35	FOUNDATION	TUBULAR STEEL Ø (IN) 3.00 (LB / FT) 7.60	TUBULAR STEEL Ø (IN) 3.50 (LB / FT) 9.00	TUBULAR STEEL Ø (IN) 4.00 (LB / FT) 10.80	TUBULAR STEEL Ø (IN) 5.00 (LB / FT) 14.60	SIGN FRAME REQUIRED	REMARKS	SIGN DETAIL LOCATION SHSM	SIGN DETAIL LOCATION SIGN DETAILS SHEET #	SIGN DETAIL LOCATION STANDARD SHEET #
NB CLARENDON VT ROUTE 7B							FY-FLUORESCENT YELLOW FYG-FLUORESCENT YELLOW GREEN																				"SHSM"-STANDARD HIGHWAY SIGNS AND MARKINGS BOOK			
		A	M4-5	24	12			2.00																			TO, BLACK ON WHITE INSTALL ON LEFT POST	X		
		A	M1-4	24	24			4.00																			INSTALL ON LEFT POST	X		
		A	M6-1L	21	15			2.19																			ARROW, BLACK ON WHITE. INSTALL ON LEFT POST	X		
		A	M3-1	24	12		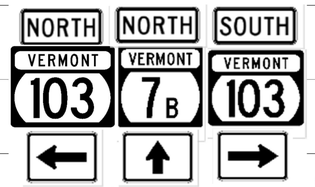 11/27/17	2.00																		NORTH, GREEN ON WHITE	X		
		A	VM1-5	24	24			4.00																						E-136I
		A	M6-3	21	15		4/9/18	2.19																			ARROW, GREEN ON WHITE	X		
		A	M3-3	24	12		11/27/17	2.00																			SOUTH, GREEN ON WHITE	X		
		A	VM1-5	30	24			5.00																						E-136I
		A	M6-1R	21	15			2.19																			ARROW, GREEN ON WHITE	X		
NB	2.896	A	R1-1										1	X																
		B	VD-700				MILE MARKER 1030 / 1105 / 0179			1																					
		A	R1-1	30	30		7/19/17	6.25																			INSTALL ON RETAINED POST	X		
		B	VD-700				MILE MARKER 1030 / 1105 / 0179			1																					
NB	2.936	A	M3-1										1		X															
		A	VM1-5										1																	
SIGN SUMMARY SHEET							SHEET TOTALS	31.81	0.00	2	0	0	3	0	0	0	0.0			0	0.0	0.0	0.0	0.0					
								SF	SF	EA	EA	EA	EA	EA	EA	EA	FT			EA	LB	LB	LB	LB					
VERMONT AGENCY OF TRANSPORTATION							TOWN DIRECTIONAL TOTALS	202.9	0.0	5	0	0	40	0	0	27	370.0			2	288.0								

PROJECT NAME: **STATEWIDE-SOUTH REGION**
PROJECT NUMBER: **STPG SIGN(57)**

FILE NAME: **z16t041Clarendon7B NB.xls** PLOT DATE: **2/27/2017**
PROJECT MANAGER: **D. MUNRO** DRAWN BY: **W. GORDON**
DESIGNED BY: **P. MCKECHNIE** CHECKED **BRZEZOWSK**
CLARENDON VT-7B NB 5 SHEET **24** OF **264**