DIRECTION	MILEPOINT	LOCATION CODE (SHEET 4)	SIGN CODE	WIDTH (IN)	HEIGHT (IN)	SHEETING REMARKS	SIGN LEGEND	NEW SIGNS "A"	NEW SIGNS "B"	EXISTING SIGNS RETAIN	EXISTING SIGNS SALVAGE FROM	EXISTING SIGNS SALVAGE TO	EXISTING SIGNS REMOVE	EXIST POST RETAIN	EXIST POST REMOVE	NUMBER OF NEW POSTS	SQUARE STEEL (IN) 1.75 (LB / FT) 1.88	SQUARE STEEL (IN) 2.00 (LB / FT) 2.42	SQUARE STEEL (IN) 2.50 (LB / FT) 3.35	FOUNDATION	TUBULAR STEEL Ø (IN) 3.00 (LB / FT) 7.60	TUBULAR STEEL Ø (IN) 3.50 (LB / FT) 9.00	TUBULAR STEEL Ø (IN) 4.00 (LB / FT) 10.80	TUBULAR STEEL Ø (IN) 5.00 (LB / FT) 14.60	SIGN FRAME REQUIRED	REMARKS	SIGN DETAIL LOCATION SHSM	SIGN DETAIL LOCATION SIGN DETAILS SHEET #	SIGN DETAIL LOCATION STANDARD SHEET #
NB CLARENDON VT ROUTE 7B							FY-FLUORESCENT YELLOW FYG-FLUORESCENT YELLOW GREEN																			"SHSM"-STANDARD HIGHWAY SIGNS AND MARKINGS BOOK			
		A	M3-1	24	12		7/20/17	2.00								1		13'-0" X							NORTH, GREEN ON WHITE	X		
		A	VM1-5	24	24			4.00																					E-136
NB	2.996	A	R2-1				7/20/17						1		X														
		A	R2-1	24	30			5.00								1		12'-0" X									X		
NB	3.371	C	VR-278				PROHIBITED						1		X														
NB	3.381	A	VD-701				7/20/17						1		X														
		A	VD-701	6	10			0.42								1	6'-9" X												T-42
NB	3.621	AB	D3-1				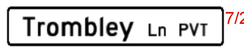 7/20/17						1		X														
		AB	D3-1	68	12			5.67								2		11'-3" 10'-3" X										6	
NB	3.751	A	R2-1				7/20/17						1		X														
		A	R2-1	24	30			5.00								1		11'-3" X									X		
NB	4.298	A	M2-1	21	15		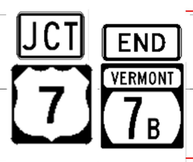 11/17/17	2.19								2		14'-9" 13'-6" X							2A	JCT, BLACK ON WHITE	X		
		A	M1-4	24	24			4.00																			INSTALL 200' DOWNSTATION FROM EXISTING SIGN AT MP 4.336 NB	X		
		A	M4-6	24	12			2.00																			END, GREEN ON WHITE	X		
		A	VM1-5	24	24			4.00																					E-136
SIGN SUMMARY SHEET							SHEET TOTALS	34.27	0.00	0	0	0	5	0	0	8		115.0		0	0.0	0.0	0.0	0.0					
								SF	SF	EA	EA	EA	EA	EA	EA	EA		FT		EA	LB	LB	LB	LB					
VERMONT AGENCY OF TRANSPORTATION							TOWN DIRECTIONAL TOTALS	202.9	0.0	5	0	0	40	0	0	27		370.0		2		288.0							

PROJECT NAME: **STATEWIDE-SOUTH REGION**
PROJECT NUMBER: **STPG SIGN(57)**
FILE NAME: **z16t041Clarendon7B NB.xls** PLOT DATE: **2/27/2017**
PROJECT MANAGER: **D. MUNRO** DRAWN BY: **W. GORDON**
DESIGNED BY: **P. MCKECHNIE** CHECKED **BRZEZOWSK**
CLARENDON VT-7B NB 6 SHEET **25** OF **264**