DIRECTION	MILEPOINT	LOCATION CODE (SHEET 4)	SIGN CODE	WIDTH (IN)	HEIGHT (IN)	SHEETING REMARKS	SIGN LEGEND	NEW SIGNS "A"	NEW SIGNS "B"	EXISTING SIGNS RETAIN	EXISTING SIGNS SALVAGE FROM	EXISTING SIGNS SALVAGE TO	EXISTING SIGNS REMOVE	EXIST POST RETAIN	EXIST POST REMOVE	NUMBER OF NEW POSTS	SQUARE STEEL (IN) 1.75 (LB / FT) 1.88	SQUARE STEEL (IN) 2.00 (LB / FT) 2.42	SQUARE STEEL (IN) 2.50 (LB / FT) 3.35	TUBULAR STEEL Ø (IN) FOUNDATION	TUBULAR STEEL Ø (IN) 3.00 (LB / FT) 7.60	TUBULAR STEEL Ø (IN) 3.50 (LB / FT) 9.00	TUBULAR STEEL Ø (IN) 4.00 (LB / FT) 10.80	TUBULAR STEEL Ø (IN) 5.00 (LB / FT) 14.60	SIGN FRAME REQUIRED	REMARKS	SIGN DETAIL LOCATION SHSM	SIGN DETAIL LOCATION SIGN DETAILS SHEET #	SIGN DETAIL LOCATION STANDARD SHEET #
NB LUDLOW VT ROUTE 103							FY-FLUORESCENT YELLOW FYG-FLUORESCENT YELLOW GREEN																			"SHSM"-STANDARD HIGHWAY SIGNS AND MARKINGS BOOK			
NB	0.000	C	VD-024				LUDLOW | CAVENDISH						1		X														
		C	VD-700				MILE MARKER 1030 / 1410 / 0000				1		1																
		C	VD-700				MILE MARKER 1030 / 1406 / 0374				1		1																
		C	VD-024	72	10		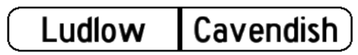 8/9/17	5.00								2		11'-9" 11'-9" X								INSTALL THIS ASSEMBLY CENTERED IN THE SAME POSITION AS THE REMOVAL			T-94
		C	VD-700				MILE MARKER 1030 / 1410 / 0000					1														INSTALL LUDLOW MILE MARKER ON THE LEFT POST UNDER LUDLOW			
		C	VD-700				MILE MARKER 1030 / 1406 / 0374					1														INSTALL CAVENDISH MILE MARKER ON THE RIGHT POST UNDER CAVENDISH			
NB	0.101	A	W3-5										1		X														
		A	W3-5	36	36			~~9.00~~								~~2~~		~~X~~								SPEED LIMIT 40 ZONE MOVED TO TOWN LINE	X		
NB	0.176	A	VD-062B				OFFICIAL BUSINESS DIRECTIONAL SIGN			1				X												Imerys Talc VT next left			
		A	VD-062B				OFFICIAL BUSINESS DIRECTIONAL SIGN			1																Andrie Rose Inn left at light			
		A	VD-062B				OFFICIAL BUSINESS DIRECTIONAL SIGN			1																Tina's Fun Stuff to Wear, left at light			
NB	0.215	A	R2-1				SPEED LIMIT 40						1	X															
		A	VD-700				MILE MARKER 1030 / 1410 / 0020			1																				
		A	R2-1	30	36		8/9/17	7.50																		INSTALL ON RETAINED POST	X		
							SHEET TOTALS	21.50 SF	0.00 SF	4 EA	2 EA	2 EA	5 EA	0 EA	0 EA	4 EA		60.0 FT		0 EA	0.0 LB	0.0 LB	0.0 LB	0.0 LB					
							TOWN DIRECTIONAL TOTALS	754.3	0.0	42	13	13	190	0	0	65		945.0		0	0.0									

SIGN SUMMARY SHEET

VERMONT AGENCY OF TRANSPORTATION

PROJECT NAME: STATEWIDE-SOUTH REGION
PROJECT NUMBER: STPG SIGN(57)

FILE NAME: z16t041Ludlow103 NB.xls
PROJECT MANAGER: D. MUNRO
DESIGNED BY: P. MCKECHNIE
LUDLOW VT-103 NB 1

PLOT DATE: 2/27/2017
DRAWN BY: W. GORDON
CHECKED BRZEZOWSK
SHEET 33 OF 264