DIRECTION	MILEPOINT	LOCATION CODE (SHEET 4)	SIGN CODE	WIDTH (IN)	HEIGHT (IN)	SHEETING REMARKS	SIGN LEGEND	NEW SIGNS		EXISTING SIGNS				EXIST POST		NUMBER OF NEW POSTS	SQUARE STEEL (IN)			TUBULAR STEEL Ø (IN)				SIGN FRAME REQUIRED	REMARKS	SIGN DETAIL LOCATION		
								"A"	"B"	RETAIN	SALVAGE FROM	SALVAGE TO	REMOVE	RETAIN	REMOVE		1.75	2.00	2.50	3.00	3.50	4.00	5.00			SHSM	SIGN DETAILS SHEET #	STANDARD SHEET #
																	(LB / FT)			(LB / FT)							
																	1.88	2.42	3.35	7.60	9.00	10.80	14.60					
NB LUDLOW VT ROUTE 103							FY-FLUORESCENT YELLOW FYG-FLUORESCENT YELLOW GREEN																		"SHSM"-STANDARD HIGHWAY SIGNS AND MARKINGS BOOK			
		A	W16-9P	24	12	FYG	(SEE IMAGE ON PREVIOUS SHEET)	2.00																	INSTALL ON RETAINED POST. PROVIDE 7' MINIMUM CLEAR HEIGHT	X		
NB	1.558	A	S1-1				SCHOOL ADVANCE WARNING						1	X														
		A	W16-7pL				LEFT DIAGONAL ARROW PLAQUE						1															
		A	S4-3				SCHOOL						1															
		A	S1-1	36	36	FYG	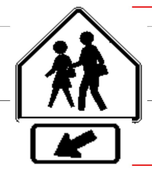 8/11/17	9.00																	INSTALL ON RETAINED POST PROVIDE 7' MINIMUM CLEAR HEIGHT	X		
		A	W16-7pL	24	12	FYG		2.00																		X		
NB	1.567	D	R1-1				STOP			1				X														
		C	R5-1				DO NOT ENTER			1																		
		A	R6-1L				<---ONE WAY			1															BACK TO BACK			
		B	R6-1R				ONE WAY -->			1																		
NB	1.592	AB	D3-1				Deep Lawn Ct			1				X											DEEP LAWN CT (TH-320)			
		D	R1-1				STOP			1																		
		C	VD-700				MILE MARKER 1030/1410/0158			1																		
NB	1.692	A	W11-2				PEDESTRIAN TRAFFIC						1	X														
SIGN SUMMARY SHEET							SHEET TOTALS	13.00	0.00	7	0	0	4	0	0	0		0.0		0	0.0	0.0	0.0	0.0					
								SF	SF	EA	EA	EA	EA	EA	EA	EA		FT		EA	LB	LB	LB	LB					
VERMONT AGENCY OF TRANSPORTATION							TOWN DIRECTIONAL TOTALS	754.3	0.0	42	13	13	190	0	0	65		945.0		0		0.0							

PROJECT NAME: **STATEWIDE-SOUTH REGION**
PROJECT NUMBER: **STPG SIGN(57)**
FILE NAME: **z16t041Ludlow103 NB.xls** PLOT DATE: **2/27/2017**
PROJECT MANAGER: **D. MUNRO** DRAWN BY: **W. GORDON**
DESIGNED BY: **P. MCKECHNIE** CHECKED **BRZEZOWSK**
LUDLOW VT-103 NB 8 SHEET **40** OF **264**