DIRECTION	MILEPOINT	LOCATION CODE (SHEET 4)	SIGN CODE	WIDTH (IN)	HEIGHT (IN)	SHEETING REMARKS	SIGN LEGEND	NEW SIGNS "A"	NEW SIGNS "B"	EXISTING SIGNS RETAIN	EXISTING SIGNS SALVAGE FROM	EXISTING SIGNS SALVAGE TO	EXISTING SIGNS REMOVE	EXIST POST RETAIN	EXIST POST REMOVE	NUMBER OF NEW POSTS	SQUARE STEEL (IN) 1.75 (LB / FT) 1.88	SQUARE STEEL (IN) 2.00 (LB / FT) 2.42	SQUARE STEEL (IN) 2.50 (LB / FT) 3.35	TUBULAR STEEL Ø (IN) FOUNDATION	TUBULAR STEEL Ø (IN) 3.00 (LB / FT) 7.60	TUBULAR STEEL Ø (IN) 3.50 (LB / FT) 9.00	TUBULAR STEEL Ø (IN) 4.00 (LB / FT) 10.80	TUBULAR STEEL Ø (IN) 5.00 (LB / FT) 14.60	SIGN FRAME REQUIRED	REMARKS	SIGN DETAIL LOCATION SHSM	SIGN DETAIL LOCATION SIGN DETAILS SHEET #	SIGN DETAIL LOCATION STANDARD SHEET #
NB LUDLOW VT ROUTE 103							FY-FLUORESCENT YELLOW FYG-FLUORESCENT YELLOW GREEN																				"SHSM"-STANDARD HIGHWAY SIGNS AND MARKINGS BOOK			
		A	W11-2	30	30	FYG	8/29/17	6.25																			INSTALL ON RETAINED POST PROVIDE 7' MINIMUM CLEAR HEIGHT	X		
		A	W16-7pL	24	12	FYG		2.00																				X		
NB	2.121	C		30	36		10/23/17	7.50																			MOUNT ON LIGHT POLE MOUNT ON POLE WITH STAINLESS STEEL BANDS.		3	
		C		12	18			1.50																			PROVIDE WORKING DRAWING DEPICTING ATTACHMENT METHOD.		3	
NB	2.156	C		30	36		10/23/17 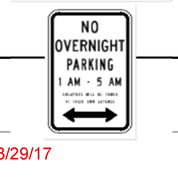	7.50																			MOUNT ON LIGHT POLE MOUNT ON POLE WITH STAINLESS STEEL BANDS.		3	
		C		12	18			1.50																			PROVIDE WORKING DRAWING DEPICTING ATTACHMENT METHOD.		3	
NB	2.185	A	R2-1				8/29/17						1	~~X~~	X												EXISTING POST MISSING ~~INSTALL ON RETAINED POST~~			
		A	R2-1	24	30			5.00								1		13'-0" X									PROVIDE 7' MINIMUM CLEAR HEIGHT	X		
NB	2.195	A	M2-1				JCT						1		X															
		A	VM1-5				VERMONT 100						1																	
		A	M2-1	21	15		8/31/17	2.19								1		13'-9" X								INSTALL 5' IN FRONT OF AND IN LINE WITH DUNKIN DONUTS SIGN. INSTALL POST AND ANCHOR IN SLEEVE. PROVIDE 7' MINIMUM CLEAR HEIGHT. JCT, GREEN ON WHITE	X		
		A	VM1-5	30	24			5.00																						E-136
NB	2.208	A	D4-1	30	24		4/9/18	5.00								1		12'-6" X								INSTALL SIGN 70' UPSATION FROM EXISTING SIGN AT MP 2.195 NB IN MULCH BETWEEN SIDEWALKS	X		
NB	2.220	A	W11-2	30	30	FYG	8/29/17	6.25								1		13'-3" X								INSTALL BEHIND SIDEWALK, 5' DOWNSTATION FROM PUSH BUTTON POLE. PROVIDE 7' MINIMUM CLEAR HEIGHT	X		
		A	W16-7pL	24	12	FYG		2.00																				X		
SIGN SUMMARY SHEET							SHEET TOTALS	51.69	0.00	0	0	0	3	0	0	3		45.0		0	0.0	0.0	0.0	0.0				
								SF	SF	EA	EA	EA	EA	EA	EA	EA		FT		EA	LB	LB	LB	LB				
VERMONT AGENCY OF TRANSPORTATION							TOWN DIRECTIONAL TOTALS	754.3	0.0	42	13	13	190	0	0	65		945.0		0	0.0							

PROJECT NAME: **STATEWIDE-SOUTH REGION**
PROJECT NUMBER: **STPG SIGN(57)**
FILE NAME: **z16t041Ludlow103 NB.xls**
PROJECT MANAGER: **D. MUNRO**
DESIGNED BY: **P. MCKECHNIE**
PLOT DATE: **2/27/2017**
DRAWN BY: **W. GORDON**
CHECKED **BRZEZOWSK**
LUDLOW VT-103 NB 12
SHEET **44** OF **264**