DIRECTION	MILEPOINT	LOCATION CODE (SHEET 4)	SIGN CODE	WIDTH (IN)	HEIGHT (IN)	SHEETING REMARKS	SIGN LEGEND	NEW SIGNS "A"	NEW SIGNS "B"	EXISTING SIGNS RETAIN	EXISTING SIGNS SALVAGE FROM	EXISTING SIGNS SALVAGE TO	EXISTING SIGNS REMOVE	EXIST POST RETAIN	EXIST POST REMOVE	NUMBER OF NEW POSTS	SQUARE STEEL (IN) 1.75 (LB / FT) 1.88	SQUARE STEEL (IN) 2.00 (LB / FT) 2.42	SQUARE STEEL (IN) 2.50 (LB / FT) 3.35	FOUNDATION	TUBULAR STEEL Ø (IN) 3.00 (LB / FT) 7.60	TUBULAR STEEL Ø (IN) 3.50 (LB / FT) 9.00	TUBULAR STEEL Ø (IN) 4.00 (LB / FT) 10.80	TUBULAR STEEL Ø (IN) 5.00 (LB / FT) 14.60	SIGN FRAME REQUIRED	REMARKS	SIGN DETAIL LOCATION SHSM	SIGN DETAIL LOCATION SIGN DETAILS SHEET #	SIGN DETAIL LOCATION STANDARD SHEET #
NB LUDLOW VT ROUTE 103							FY-FLUORESCENT YELLOW FYG-FLUORESCENT YELLOW GREEN																			"SHSM"-STANDARD HIGHWAY SIGNS AND MARKINGS BOOK			
		C	VD1-1A	72	12			6.00																				T-93
		C	M3-1	24	12			2.00																	3D	NORTH, GREEN ON WHITE	X		
		C	VM1-5	30	24			5.00																				E-136
		C	M6-1	21	15		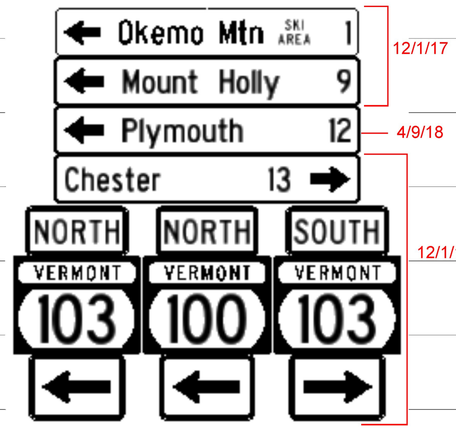 12/1/17 4/9/18 12/1/17	2.19																ARROW, GREEN ON WHITE	X		
		C	M3-3	24	12			2.00																		SOUTH, GREEN ON WHITE	X		
		C	VM1-5	30	24			5.00																				E-136
		C	M6-1	21	15			2.19																		ARROW, GREEN ON WHITE	X		
NB	2.245	A	VD-701				BRIDGE / 26 / VT-103						1		X														
		A	VD-701	6	10		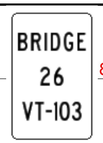 8/29/17	0.42								1	6'-9" X								T-42
NB	2.265	A	W11-2				PEDESTRIAN TRAFFIC (SOLAR POWERED)			1				X															
		A	W16-7pL				LEFT DIAGONAL ARROW PLAQUE			1																			
NB	2.285	C	R7-1				NO PARKING ANYTIME <--->						1		X												RETURN SIGN TO TOWN			
							SHEET TOTALS	33.98 SF	0.00 SF	2 EA	0 EA	0 EA	2 EA	0 EA	0 EA	1 EA		10.0 FT		0 EA	0.0 LB	0.0 LB	0.0 LB	0.0 LB				
							TOWN DIRECTIONAL TOTALS	754.3	0.0	42	13	13	190	0	0	65		945.0		0	0.0							

SIGN SUMMARY SHEET

VERMONT AGENCY OF TRANSPORTATION

PROJECT NAME: STATEWIDE-SOUTH REGION
PROJECT NUMBER: STPG SIGN(57)

FILE NAME: z16t041Ludlow103 NB.xls
PROJECT MANAGER: D. MUNRO
DESIGNED BY: P. MCKECHNIE
LUDLOW VT-103 NB 16

PLOT DATE: 2/27/2017
DRAWN BY: W. GORDON
CHECKED BRZEZOWSK