| DIRECTION | MILEPOINT | LOCATION CODE (SHEET 4) | SIGN CODE | WIDTH (IN) | HEIGHT (IN) | SHEETING REMARKS | SIGN LEGEND | NEW SIGNS "A" | NEW SIGNS "B" | EXISTING SIGNS RETAIN | EXISTING SIGNS SALVAGE FROM | EXISTING SIGNS SALVAGE TO | EXISTING SIGNS REMOVE | EXIST POST RETAIN | EXIST POST REMOVE | NUMBER OF NEW POSTS | SQUARE STEEL (IN) 1.75 (LB / FT) 1.88 | SQUARE STEEL (IN) 2.00 (LB / FT) 2.42 | SQUARE STEEL (IN) 2.50 (LB / FT) 3.35 | FOUNDATION | TUBULAR STEEL Ø (IN) 3.00 (LB / FT) 7.60 | TUBULAR STEEL Ø (IN) 3.50 (LB / FT) 9.00 | TUBULAR STEEL Ø (IN) 4.00 (LB / FT) 10.80 | TUBULAR STEEL Ø (IN) 5.00 (LB / FT) 14.60 | SIGN FRAME REQUIRED | REMARKS | SIGN DETAIL LOCATION SHSM | SIGN DETAIL LOCATION SIGN DETAILS SHEET # | SIGN DETAIL LOCATION STANDARD SHEET # |
|---|---|---|---|---|---|---|---|---|---|---|---|---|---|---|---|---|---|---|---|---|---|---|---|---|---|---|---|---|---|
| **NB LUDLOW VT ROUTE 103** | | | | | | | FY-FLUORESCENT YELLOW<br>FYG-FLUORESCENT YELLOW GREEN | | | | | | | | | | | | | | | | | | | "SHSM"-STANDARD HIGHWAY SIGNS AND MARKINGS BOOK | | | |
| | | C | M6-1 | | | | RIGHT ARROW | | | | | | 1 | | | | | | | | | | | | | | | | |
| | | C | M4-5 | | | | TO | | | | | | 1 | | | | | | | | | | | | | | | | |
| | | C | M1-1 | | | | I-91 | | | | | | 1 | | | | | | | | | | | | | | | | |
| | | C | M6-1 | | | | RIGHT ARROW | | | | | | 1 | | | | | | | | | | | | | | | | |
| NB | 2.629 | C | M3-1 | 24 | 12 | | | 2.00 | | | | | | | | | | | | | | | | | 3D | INSTALL ON RETAINED POSTS;<br>NORTH, GREEN ON WHITE; | X | | |
| | | C | VM1-5 | 30 | 24 | | | 5.00 | | | | | | | | | | | | | | | | | | SIGN FRAME WILL NEED TO BE MODIFIED TO ACCOMMODATE ASSEMBLY SHOWN | | | E-136 |
| | | C | M6-1 | 21 | 15 | | | 2.19 | | | | | | | | | | | | | | | | | | ARROW, GREEN ON WHITE | X | | |
| | | C | M3-1 | 24 | 12 | | | 2.00 | | | | | | | | | | | | | | | | | | NORTH, GREEN ON WHITE | X | | |
| | | C | VM1-5 | 30 | 24 | | | 5.00 | | | | | | | | | | | | | | | | | | | | | E-136 |
| | | C | M6-1 | 21 | 15 | | | 2.19 | | | | | | | | | | | | | | | | | | ARROW, GREN ON WHITE | X | | |
| | | C | M3-3 | 24 | 12 | | | 2.00 | | | | | | | | | | | | | | | | | | SOUTH, GREEN ON WHITE | X | | |
| | | C | VM1-5 | 30 | 24 | | | 5.00 | | | | | | | | | | | | | | | | | | | | | E-136 |
| | | C | M6-1 | 21 | 15 | | | 2.19 | | | | | | | | | | | | | | | | | | ARROW, GREEN ON WHITE | X | | |
| | | C | M3-3 | 24 | 12 | | | 2.00 | | | | | | | | | | | | | | | | | | SOUTH, GREEN ON WHITE | X | | |
| | | C | VM1-5 | 30 | 24 | | | 5.00 | | | | | | | | | | | | | | | | | | | | | E-136 |
| **SIGN SUMMARY SHEET** | | | | | | | SHEET TOTALS | 34.56 | 0.00 | 0 | 0 | 0 | 4 | 0 | 0 | 0 | | 0.0 | | | 0 | 0.0 | 0.0 | 0.0 | 0.0 | | | | | |
| | | | | | | | | SF | SF | EA | EA | EA | EA | EA | EA | EA | | FT | | | EA | LB | LB | LB | LB | | | | | |
| VERMONT AGENCY OF TRANSPORTATION | | | | | | | TOWN DIRECTIONAL TOTALS | 754.3 | 0.0 | 42 | 13 | 13 | 190 | 0 | 0 | 65 | | 945.0 | | | 0 | 0.0 | | | | | | | | |

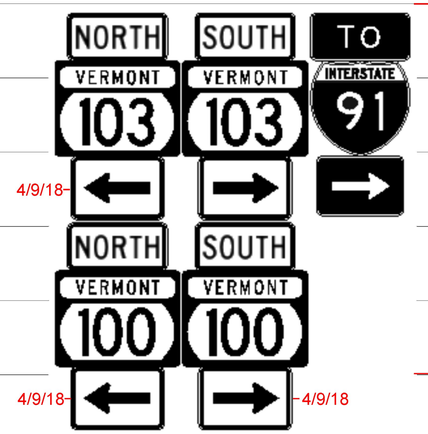


4/9/18 — 4/9/18 — 12/1/17 — 4/9/18 — 4/9/18

PROJECT NAME: STATEWIDE-SOUTH REGION
PROJECT NUMBER: STPG SIGN(57)
FILE NAME: z16t041Ludlow103 NB.xls
PROJECT MANAGER: D. MUNRO
DESIGNED BY: P. MCKECHNIE
LUDLOW VT-103 NB 20
PLOT DATE: 2/27/2017
DRAWN BY: W. GORDON
CHECKED BRZEZOWSK
SHEET 52 OF 264