DIRECTION	MILEPOINT	LOCATION CODE (SHEET 4)	SIGN CODE	WIDTH (IN)	HEIGHT (IN)	SHEETING REMARKS	SIGN LEGEND	NEW SIGNS "A"	NEW SIGNS "B"	EXISTING SIGNS RETAIN	EXISTING SIGNS SALVAGE FROM	EXISTING SIGNS SALVAGE TO	EXISTING SIGNS REMOVE	EXIST POST RETAIN	EXIST POST REMOVE	NUMBER OF NEW POSTS	SQUARE STEEL (IN) 1.75 (LB / FT) 1.88	SQUARE STEEL (IN) 2.00 (LB / FT) 2.42	SQUARE STEEL (IN) 2.50 (LB / FT) 3.35	FOUNDATION	TUBULAR STEEL Ø (IN) 3.00 (LB / FT) 7.60	TUBULAR STEEL Ø (IN) 3.50 (LB / FT) 9.00	TUBULAR STEEL Ø (IN) 4.00 (LB / FT) 10.80	TUBULAR STEEL Ø (IN) 5.00 (LB / FT) 14.60	SIGN FRAME REQUIRED	REMARKS	SIGN DETAIL LOCATION SHSM	SIGN DETAIL LOCATION SIGN DETAILS SHEET #	SIGN DETAIL LOCATION STANDARD SHEET #
NB LUDLOW VT ROUTE 103							FY-FLUORESCENT YELLOW FYG-FLUORESCENT YELLOW GREEN																			"SHSM"-STANDARD HIGHWAY SIGNS AND MARKINGS BOOK			
		A	VM1-5				VERMONT 100						1																
		A	M6-1				RIGHT ARROW						1																
		A	M3-1	24	12			2.00																	2C	INSTALL ON RETAINED POSTS NORTH, GREEN ON WHITE	X		
		A	VM1-5	30	24		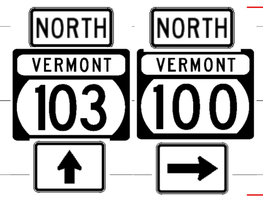 10/24/17	5.00																				E-136
		A	M6-3	21	15			2.19																		UP ARROW, GREEN ON WHITE	X		
		A	M3-1	24	12			2.00																		NORTH, GREEN ON WHITE	X		
		A	VM1-5	30	24			5.00																					E-136
		A	M6-1	21	15			2.19																		RIGHT ARROW, GREEN ON WHITE	X		
NB	3.952	J	R4-7				KEEP RIGHT						1	X															
		J	OM1-1				OBJECT MARKER			1																			
		K	OM1-1				OBJECT MARKER			1																			
		JK					DELINEATORS			1																BACK TO BACK DELINEATORS			
		J	R4-7	24	30		8/24/17	5.00																		INSTALL ABOVE RETAINED OBJECT MARKER ON RETAINED POST	X		
NB	3.986	A	VR-922R				LANE ASSIGNMENT						1	X															
		A	VR-922R	36	30		8/24/17	7.50																		INSTALL ON RETAINED POST			E-145
							SHEET TOTALS	30.88	0.00	3	0	0	4	0	0	0	0.0			0	0.0	0.0	0.0	0.0				
								SF	SF	EA	EA	EA	EA	EA	EA	EA	FT			EA	LB	LB	LB	LB				
							TOWN DIRECTIONAL TOTALS	754.3	0.0	42	13	13	190	0	0	65	945.0			0	0.0							

SIGN SUMMARY SHEET

VERMONT AGENCY OF TRANSPORTATION

PROJECT NAME: **STATEWIDE-SOUTH REGION**
PROJECT NUMBER: **STPG SIGN(57)**

FILE NAME: **z16t041Ludlow103 NB.xls**
PROJECT MANAGER: **D. MUNRO**
DESIGNED BY: **P. MCKECHNIE**
LUDLOW VT-103 NB 26

PLOT DATE: **2/27/2017**
DRAWN BY: **W. GORDON**
CHECKED **BRZEZOWSK**