| DIRECTION | MILEPOINT | LOCATION CODE (SHEET 4) | SIGN CODE | WIDTH (IN) | HEIGHT (IN) | SHEETING REMARKS | SIGN LEGEND | NEW SIGNS "A" | NEW SIGNS "B" | EXISTING SIGNS RETAIN | EXISTING SIGNS SALVAGE FROM | EXISTING SIGNS SALVAGE TO | EXISTING SIGNS REMOVE | EXIST POST RETAIN | EXIST POST REMOVE | NUMBER OF NEW POSTS | SQUARE STEEL (IN) 1.75 (LB / FT) 1.88 | SQUARE STEEL (IN) 2.00 (LB / FT) 2.42 | SQUARE STEEL (IN) 2.50 (LB / FT) 3.35 | FOUNDATION | TUBULAR STEEL Ø (IN) 3.00 (LB / FT) 7.60 | TUBULAR STEEL Ø (IN) 3.50 (LB / FT) 9.00 | TUBULAR STEEL Ø (IN) 4.00 (LB / FT) 10.80 | TUBULAR STEEL Ø (IN) 5.00 (LB / FT) 14.60 | SIGN FRAME REQUIRED | REMARKS | SIGN DETAIL LOCATION SHSM | SIGN DETAIL LOCATION SIGN DETAILS SHEET # | SIGN DETAIL LOCATION STANDARD SHEET # |
|---|---|---|---|---|---|---|---|---|---|---|---|---|---|---|---|---|---|---|---|---|---|---|---|---|---|---|---|---|---|
| **SB LUDLOW VT ROUTE 103** | | | | | | | FY-FLUORESCENT YELLOW<br>FYG-FLUORESCENT YELLOW GREEN | | | | | | | | | | | | | | | | | | | | "SHSM"-STANDARD HIGHWAY SIGNS AND MARKINGS BOOK | | | |
| SB | 5.604 | F | VW-092 | | | | UNSAFE TO PASS | | | 1 | | | | X | | | | | | | | | | | | | | | |
| SB | 5.280 | F | VW-092 | | | | UNSAFE TO PASS | | | 1 | | | | X | | | | | | | | | | | | | | | |
| SB | 5.126 | F | VD-062B | | | | OFFICIAL BUSINESS DIRECTIONAL SIGN | | | 1 | | | | X | | | | | | | | | | | | | Coleman Brook Tavern | | | |
| | | F | VD-062B | | | | OFFICIAL BUSINESS DIRECTIONAL SIGN | | | 1 | | | | | | | | | | | | | | | | | Jackson Gore Inn | | | |
| | | F | VD-062B | | | | OFFICIAL BUSINESS DIRECTIONAL SIGN | | | 1 | | | | | | | | | | | | | | | | | Jackson Gore Real Estate | | | |
| SB | 4.694 | F | R2-1 | | | | 8/28/17 | | | | | | 1 | | X | | | | | | | | | | | | | | | |
| | | F | R2-1 | 24 | 30 | | | 5.00 | | | | | | | | 1 | | 13'-3"<br>X | | | | | | | | | | X | | |
| SB | 4.522 | F | W6-1 | | | | DIVIDED HIGHWAY | | | | | | 1 | | X | | | | | | | | | | | | | | | |
| SB | 4.487 | F | W2-7L | | | | INTERSECTION WARNING SIGN | | | | | | 1 | | X | | | | | | | | | | | | | | | |
| | | F | W16-8 | | | | <--BUTTERMILK FALLS RD | | | | | | 1 | | | | | | | | | | | | | | | | | |
| | | F | W16-8 | | | | OKEMO RIDGE RD --> | | | | | | 1 | | | | | | | | | | | | | | | | | |
| | | F | W2-1MdL | 30 | 30 | | 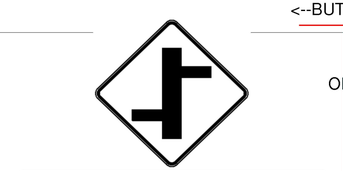 8/28/17 | 6.25 | | | | | | | | 2 | 14'-6"<br>13'-9"<br>X | | | | | | | | | | 2 | |
| | | F | W16-8aP | 64 | 15 | | | 6.67 | | | | | | | | | | | | | | | | | | | | 5 | |
| SB | 4.448 | F | VD-062B | | | | 8/28/17 OFFICIAL BUSINESS DIRECTIONAL SIGN | | | 1 | | | | X | | | | | | | | | | | | Inn at Water's Edge, VT 100 no. | | | |
| SB | 4.390 | F | W6-1 | 36 | 36 | | | 9.00 | | | | | | | | 2 | 15'-3"<br>14'-6"<br>X | | | | | | | | | | INSTALL SIGN ±245' DOWNSTATION FROM EXISTING SIGN AT MP 4.436 SB | X | | |
| | | | | | | | SHEET TOTALS | 26.92 SF | 0.00 SF | 6 EA | 0 EA | 0 EA | 5 EA | 0 EA | 0 EA | 5 EA | 75.0 FT | | 0 EA | 0.0 LB | 0.0 LB | 0.0 LB | 0.0 LB | | | | |
| | | | | | | | TOWN DIRECTIONAL TOTALS | 502.1 | 0.0 | 48 | 5 | 5 | 120 | 0 | 0 | 62 | 870.0 | | 2 | 217.0 | | | | | | | |

## SIGN SUMMARY SHEET

VERMONT AGENCY OF TRANSPORTATION

PROJECT NAME: STATEWIDE-SOUTH REGION
PROJECT NUMBER: STPG SIGN(57)

FILE NAME: z16t041Ludlow103 SB.xls
PROJECT MANAGER: D. MUNRO
DESIGNED BY: P. MCKECHNIE
LUDLOW VT-103 SB 1

PLOT DATE: 2/27/2017
DRAWN BY: W. GORDON
CHECKED BRZEZOWSK
SHEET 62 OF 264