DIRECTION	MILEPOINT	LOCATION CODE (SHEET 4)	SIGN CODE	WIDTH (IN)	HEIGHT (IN)	SHEETING REMARKS	SIGN LEGEND	NEW SIGNS "A"	NEW SIGNS "B"	EXISTING SIGNS RETAIN	EXISTING SIGNS SALVAGE FROM	EXISTING SIGNS SALVAGE TO	EXISTING SIGNS REMOVE	EXIST POST RETAIN	EXIST POST REMOVE	NUMBER OF NEW POSTS	SQUARE STEEL (IN) 1.75 (LB / FT) 1.88	SQUARE STEEL (IN) 2.00 (LB / FT) 2.42	SQUARE STEEL (IN) 2.50 (LB / FT) 3.35	TUBULAR STEEL Ø (IN) FOUNDATION	TUBULAR STEEL Ø (IN) 3.00 (LB / FT) 7.60	TUBULAR STEEL Ø (IN) 3.50 (LB / FT) 9.00	TUBULAR STEEL Ø (IN) 4.00 (LB / FT) 10.80	TUBULAR STEEL Ø (IN) 5.00 (LB / FT) 14.60	SIGN FRAME REQUIRED	REMARKS	SIGN DETAIL LOCATION SHSM	SIGN DETAIL LOCATION SIGN DETAILS SHEET #	SIGN DETAIL LOCATION STANDARD SHEET #
SB LUDLOW VT ROUTE 103							FY-FLUORESCENT YELLOW FYG-FLUORESCENT YELLOW GREEN																				"SHSM"-STANDARD HIGHWAY SIGNS AND MARKINGS BOOK			
SB	2.736	F	VD-701				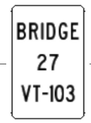 8/23/17						1		X														
		F	VD-701	6	10			0.42								1	7'-6" X												T-42
SB	2.722	G	R7-1				NO PARKING ANYTIME <--->						1		X														
		G	R7-201				8/23/17 TOW AWAY ZONE PLAQUE						1														
		G	R7-1	12	18			1.50								1		12'-6" X								NOTE: DOUBLE HEADED ARROW. PROVIDE 7' MINIMUM CLEAR HEIGHT	X		
		G	R7-201	12	6			0.50																			X		
SB	2.687	F	W11-2				PEDESTRIAN TRAFFIC						1	X															
		F	W16-7pL				ARROW PLAQUE						1																
		F	W11-2	30	30	FYG	8/23/17	6.25																			INSTALL ON RETAINED POST PROVIDE 7' MINIMUM CLEAR HEIGHT	X		
		F	W16-7pL	24	12	FYG		2.00																			X		
SB	2.672	F	VD1-1Sa				OKEMO MTN SKI AREA -->						1		X														
SB	2.658	F	VD1-1Sa	72	12		8/28/17	6.00								2	12'-9" 12'-3" X								INSTALL 75' SOUTH OF EXISTING SIGN AT MP 2.672 SB. PROVIDE 7' MINIMUM CLEAR HEIGHT		3	
SB	2.647	FE	D3-1				Mountain Rd TH2			1				X													WOODEN SIGN ON WOOD POST			
SB	2.627	FE	D3-1				Mountain Rd			1				X													MOUNTAIN RD (TH-2)			
		H	R1-1				STOP						1																
							SHEET TOTALS	16.67	0.00	2	0	0	7	0	0	4		55.0		0	0.0	0.0	0.0	0.0					
								SF	SF	EA	EA	EA	EA	EA	EA	EA		FT		EA	LB	LB	LB	LB					
							TOWN DIRECTIONAL TOTALS	502.1	0.0	48	5	5	120	0	0	62		870.0		2	217.0								

SIGN SUMMARY SHEET

VERMONT AGENCY OF TRANSPORTATION

PROJECT NAME: **STATEWIDE-SOUTH REGION**
PROJECT NUMBER: **STPG SIGN(57)**
FILE NAME: **z16t041Ludlow103 SB.xls**
PROJECT MANAGER: **D. MUNRO**
DESIGNED BY: **P. MCKECHNIE**
LUDLOW VT-103 SB 7
PLOT DATE: **2/27/2017**
DRAWN BY: **W. GORDON**
CHECKED **BRZEZOWSK**
SHEET **68** OF **264**