DIRECTION	MILEPOINT	LOCATION CODE (SHEET 4)	SIGN CODE	WIDTH (IN)	HEIGHT (IN)	SHEETING REMARKS	SIGN LEGEND	NEW SIGNS "A"	NEW SIGNS "B"	EXISTING SIGNS RETAIN	EXISTING SIGNS SALVAGE FROM	EXISTING SIGNS SALVAGE TO	EXISTING SIGNS REMOVE	EXIST POST RETAIN	EXIST POST REMOVE	NUMBER OF NEW POSTS	SQUARE STEEL (IN) 1.75 (LB / FT) 1.88	SQUARE STEEL (IN) 2.00 (LB / FT) 2.42	SQUARE STEEL (IN) 2.50 (LB / FT) 3.35	FOUNDATION	TUBULAR STEEL Ø (IN) 3.00 (LB / FT) 7.60	TUBULAR STEEL Ø (IN) 3.50 (LB / FT) 9.00	TUBULAR STEEL Ø (IN) 4.00 (LB / FT) 10.80	TUBULAR STEEL Ø (IN) 5.00 (LB / FT) 14.60	SIGN FRAME REQUIRED	REMARKS	SIGN DETAIL LOCATION SHSM	SIGN DETAIL LOCATION SIGN DETAILS SHEET #	SIGN DETAIL LOCATION STANDARD SHEET #
SB LUDLOW VT ROUTE 103							FY-FLUORESCENT YELLOW FYG-FLUORESCENT YELLOW GREEN																				"SHSM"-STANDARD HIGHWAY SIGNS AND MARKINGS BOOK			
SB	1.794	F	R2-1				SPEED LIMIT 30						1		X														
SB	1.756	F	R2-1	24	30		8/30/17	5.00								1		12'-9" X								INSTALL IN GRASS BEHIND SIDEWALK 10' UPSTATION FROM UTILITY POLE. PROVIDE 7' MINIMUM CLEAR HEIGHT	X		
SB	1.700	F	W11-2				PEDESTRIAN TRAFFIC						1	~~X~~	X														
		F	W16-7pL				LEFT DIAGONAL ARROW PLAQUE						1																	
SB	1.700	F	D3-1	28	12		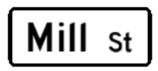 8/14/17	2.33								1		11'-0" X								MILL ST (TH-324) ~~INSTALL ON RETAINED POST AT LOCATION OF REMOVED PEDESTRIAN WARNING SIGN.~~ PROVIDE 7' MINIMUM CLEAR HEIGHT. INSTALLED ON NEW POST		7	
SB	1.694	F	W11-2	30	30	FYG	8/30/17	6.25								1		14'-0" X								~~INSTALL AT LOCATION OF EXISTING STOP SIGN AT MP 1.694 SB.~~ PROVIDE 7' MINIMUM CLEAR HEIGHT INSTALLED AT EXISTING PED TRAFFIC SIGN LOCATION	X		
		F	W16-7pL	24	12	FYG		2.00																			X		
SB	1.694	FE	D3-1				MILL ST						1		X														
		H	R1-1				STOP						1																
		F	VD-700				MILE MARKER 1030/1410/0168				1		1														INSTALLED AT EXISTING STOP SIGN LOCATION			
		H	R1-1	30	30		8/30/17	6.25								1		12'-3" X								~~INSTALL 8' FURTHER DOWN MILL STREET.~~ PROVIDE 7' MINIMUM CLEAR HEIGHT	X		
		F	VD-700				MILE MARKER 1030/1410/0168					1															INSTALL SALVAGED MILE MARKER BACK TO BACK ON STOP SIGN POST			
SB	1.680	G	R7-1							1			~~1~~	X	~~X~~													EXISTING SIGN AND POST RETAINED			
		G	R7-1	~~12~~	~~18~~			~~1.50~~								~~1~~		~~X~~								NOTE: DOUBLE HEADED ARROW PROVIDE 7' MINIMUM CLEAR HEIGHT	X		
							SHEET TOTALS	23.33	0.00	0	1	1	7	0	0	4		60.0		0	0.0	0.0	0.0	0.0					
								SF	SF	EA	EA	EA	EA	EA	EA	EA		FT		EA	LB	LB	LB	LB					
							TOWN DIRECTIONAL TOTALS	502.1	0.0	48	5	5	120	0	0	62		870.0		2	217.0								

SIGN SUMMARY SHEET

VERMONT AGENCY OF TRANSPORTATION

PROJECT NAME: **STATEWIDE-SOUTH REGION**
PROJECT NUMBER: **STPG SIGN(57)**
FILE NAME: **z16t041Ludlow103 SB.xls**
PROJECT MANAGER: **D. MUNRO**
DESIGNED BY: **P. MCKECHNIE**
LUDLOW VT-103 SB 17
PLOT DATE: **2/27/2017**
DRAWN BY: **W. GORDON**
CHECKED **BRZEZOWSK**