DIRECTION	MILEPOINT	LOCATION CODE (SHEET 4)	SIGN CODE	WIDTH (IN)	HEIGHT (IN)	SHEETING REMARKS	SIGN LEGEND	NEW SIGNS "A"	NEW SIGNS "B"	EXISTING SIGNS RETAIN	EXISTING SIGNS SALVAGE FROM	EXISTING SIGNS SALVAGE TO	EXISTING SIGNS REMOVE	EXIST POST RETAIN	EXIST POST REMOVE	NUMBER OF NEW POSTS	SQUARE STEEL (IN) 1.75 (LB / FT) 1.88	SQUARE STEEL (IN) 2.00 (LB / FT) 2.42	SQUARE STEEL (IN) 2.50 (LB / FT) 3.35	TUBULAR STEEL Ø (IN) FOUNDATION	TUBULAR STEEL Ø (IN) 3.00 (LB / FT) 7.60	TUBULAR STEEL Ø (IN) 3.50 (LB / FT) 9.00	TUBULAR STEEL Ø (IN) 4.00 (LB / FT) 10.80	TUBULAR STEEL Ø (IN) 5.00 (LB / FT) 14.60	SIGN FRAME REQUIRED	REMARKS	SIGN DETAIL LOCATION SHSM	SIGN DETAIL LOCATION SIGN DETAILS SHEET #	SIGN DETAIL LOCATION STANDARD SHEET #
SB LUDLOW VT ROUTE 103							FY-FLUORESCENT YELLOW FYG-FLUORESCENT YELLOW GREEN																			"SHSM"-STANDARD HIGHWAY SIGNS AND MARKINGS BOOK			
SB	1.171	F	W1-10R				MODIFIED CURVE WARNING						1		X														
		F	W16-8				PREEDOM HILL ROAD						1																
SB	1.141	F	VD-062B				OFFICIAL BUSINESS DIRECTIONAL SIGN			1				X												LaValley's Ludlow Building Supply			
SB	1.104	F	W1-10R	36	36		8/14/17	9.00								2		14'-9" 14'-6" X								INSTALL SIGN ±350' DOWNSTATION OF EXISTING SIGN AT MP 1.171 SB	X		
		F	W16-8p	36	8			2.00																				5	
SB	1.049	F	W11-6				SNOWMOBILE CROSSING						1		X														
		F	W11-6	30	30		8/14/17	6.25								1		14'-3" X								**FOLDING / HINGED SIGN**	X		
SB	1.005	F	W2-2				T-INTERSECTION SIGN						1		X														
		F	W16-8				PLEASANT STREET EXT.						1																
		F	W2-2	36	36		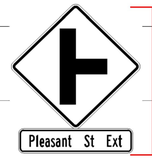 8/16/17	9.00								2		17'-0" 13'-9" X									X		
		F	W16-8p	36	8			2.00																				5	
SB	0.986	G	VR-017	24	30		8/16/17	5.00								1		12'-0" X								PLEASANT ST EXT (TH-26) INSTALL NEW SIGN BEHIND GUARDRAIL ON LEGAL LOAD SIDE OF INTERSECTION	X		
SB	0.975	FE	D3-1				Pleasant St Ext			1				X															
		H	R1-1				STOP			1																			
		F	VD-700				MILE MARKER 1030 / 1410 / 0097			1																				
SIGN SUMMARY SHEET							SHEET TOTALS	33.25	0.00	4	0	0	5	0	0	6		90.0		0	0.0	0.0	0.0	0.0					
								SF	SF	EA	EA	EA	EA	EA	EA	EA		FT		EA	LB	LB	LB	LB					
VERMONT AGENCY OF TRANSPORTATION							TOWN DIRECTIONAL TOTALS	502.1	0.0	48	5	5	120	0	0	62		870.0		2	217.0								

PROJECT NAME: **STATEWIDE-SOUTH REGION**
PROJECT NUMBER: **STPG SIGN(57)**
FILE NAME: **z16t041Ludlow103 SB.xls** PLOT DATE: **2/27/2017**
PROJECT MANAGER: **D. MUNRO** DRAWN BY: **W. GORDON**
DESIGNED BY: **P. MCKECHNIE** CHECKED **BRZEZOWSK**
LUDLOW VT-103 SB 19 SHEET **80** OF **264**