DIRECTION	MILEPOINT	LOCATION CODE (SHEET 4)	SIGN CODE	WIDTH (IN)	HEIGHT (IN)	SHEETING REMARKS	SIGN LEGEND	NEW SIGNS "A"	NEW SIGNS "B"	EXISTING SIGNS RETAIN	EXISTING SIGNS SALVAGE FROM	EXISTING SIGNS SALVAGE TO	EXISTING SIGNS REMOVE	EXIST POST RETAIN	EXIST POST REMOVE	NUMBER OF NEW POSTS	SQUARE STEEL (IN) (LB / FT) 1.75 / 1.88	2.00 / 2.42	2.50 / 3.35	FOUNDATION	TUBULAR STEEL Ø (IN) (LB / FT) 3.00 / 7.60	3.50 / 9.00	4.00 / 10.80	5.00 / 14.60	SIGN FRAME REQUIRED	REMARKS	SIGN DETAIL LOCATION SHSM	SIGN DETAILS SHEET #	STANDARD SHEET #
SB LUDLOW VT ROUTE 103							FY-FLUORESCENT YELLOW FYG-FLUORESCENT YELLOW GREEN																			"SHSM"-STANDARD HIGHWAY SIGNS AND MARKINGS BOOK			
SB	0.960	F	VD-701				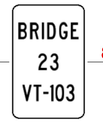 8/16/17						1		X														
		F	VD-701	6	10			0.42								1	7'-6" X												T-42
SB	0.945	F	M3-3				SOUTH						1		X														
		F	VM1-5				VERMONT 103						1																
		F	M3-3	24	12		8/14/17	2.00								1		14'-0" X								SOUTH, GREEN ON WHITE	X		
		F	VM1-5	30	24			5.00																					E-136
SB	0.921	F	VD-062B				OFFICIAL BUSINESS DIRECTIONAL SIGN			1				X												Imerys Talc VT next right			
SB	0.830	F	R2-1				8/16/17						1		X														
		F	R2-1	24	30			5.00								1		15'-3" X									X		
SB	0.539	F	VW-205				8/17/17						1		X														
		F	VW-205	36	36			9.00								2		12'-9" 11'-6" X											T-82
SB	0.466	F	R2-1				8/15/17						1		X														
		F	R2-1	24	30		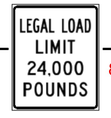	5.00								1		11'-6" X									X		
SB	0.339	G	VR-017	24	30		8/15/17	5.00								1		13'-3" X								EAST HILL RD (TH-29) INSTALL ON LEGAL LOAD SIDE OF THE TOWN HIGHWAY			T-70
							SHEET TOTALS	31.42	0.00	1	0	0	6	0	0	7		100.0		0	0.0	0.0	0.0	0.0					
								SF	SF	EA	EA	EA	EA	EA	EA	EA		FT		EA	LB	LB	LB	LB					
							TOWN DIRECTIONAL TOTALS	502.1	0.0	48	5	5	120	0	0	62		870.0		2	217.0								

SIGN SUMMARY SHEET

VERMONT AGENCY OF TRANSPORTATION

PROJECT NAME: STATEWIDE-SOUTH REGION
PROJECT NUMBER: STPG SIGN(57)

FILE NAME: z16t041Ludlow 103 SB.xls
PROJECT MANAGER: D. MUNRO
DESIGNED BY: P. MCKECHNIE
LUDLOW VT-103 SB 20

PLOT DATE: 2/27/2017
DRAWN BY: W. GORDON
CHECKED BRZEZOWSK