DIRECTION	MILEPOINT	LOCATION CODE (SHEET 4)	SIGN CODE	WIDTH (IN)	HEIGHT (IN)	SHEETING REMARKS	SIGN LEGEND	NEW SIGNS "A"	NEW SIGNS "B"	EXISTING SIGNS RETAIN	EXISTING SIGNS SALVAGE FROM	EXISTING SIGNS SALVAGE TO	EXISTING SIGNS REMOVE	EXIST POST RETAIN	EXIST POST REMOVE	NUMBER OF NEW POSTS	SQUARE STEEL (IN) (LB / FT) 1.75 / 1.88	2.00 / 2.42	2.50 / 3.35	FOUNDATION	TUBULAR STEEL Ø (IN) (LB / FT) 3.00 / 7.60	3.50 / 9.00	4.00 / 10.80	5.00 / 14.60	SIGN FRAME REQUIRED	REMARKS	SIGN DETAIL LOCATION SHSM	SIGN DETAILS SHEET #	STANDARD SHEET #
SB MOUNT HOLLY VT 103							FY-FLUORESCENT YELLOW FYG-FLUORESCENT YELLOW GREEN																			"SHSM"-STANDARD HIGHWAY SIGNS AND MARKINGS BOOK			
SB	0.149	F	VW-092				8/21/17						1	X	X											REMOVE LEFT POST RETAIN RIGHT POST			
		F	VW-092	30	30			6.25																		INSTALL ON RETAINED POST			T-81
SB	0.044	F	VD-701				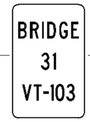 9/5/17						1	~~X~~	X														
		F	VD-701	6	10			0.42								1	7'-6" X									~~INSTALL ON RETAINED POSTS~~			T-42
							SHEET TOTALS	6.67	0.00	0	0	0	2	0	0	0	0.0			0	0.0	0.0	0.0	0.0					
								SF	SF	EA	EA	EA	EA	EA	EA	EA	FT			EA	LB	LB	LB	LB					
							TOWN DIRECTIONAL TOTALS	367.7	0.0	11	4	5	82	0	0	41	585.0			0	0.0								

SIGN SUMMARY SHEET

VERMONT AGENCY OF TRANSPORTATION

PROJECT NAME: STATEWIDE-SOUTH REGION
PROJECT NUMBER: STPG SIGN(57)
FILE NAME: z16t041Mt Hollv103 SB.xls
PROJECT MANAGER: D. MUNRO
DESIGNED BY: P. MCKECHNIE
MOUNT HOLLY VT-103 SB 13
PLOT DATE: 2/27/2017
DRAWN BY: W. GORDON
CHECKED BRZEZOWSK
SHEET 109 OF 264