DIRECTION	MILEPOINT	LOCATION CODE (SHEET 4)	SIGN CODE	WIDTH (IN)	HEIGHT (IN)	SHEETING REMARKS	SIGN LEGEND	NEW SIGNS "A"	NEW SIGNS "B"	EXISTING SIGNS RETAIN	EXISTING SIGNS SALVAGE FROM	EXISTING SIGNS SALVAGE TO	EXISTING SIGNS REMOVE	EXIST POST RETAIN	EXIST POST REMOVE	NUMBER OF NEW POSTS	SQUARE STEEL (IN) 1.75 (LB / FT) 1.88	SQUARE STEEL (IN) 2.00 (LB / FT) 2.42	SQUARE STEEL (IN) 2.50 (LB / FT) 3.35	TUBULAR STEEL Ø (IN) FOUNDATION	TUBULAR STEEL Ø (IN) 3.00 (LB / FT) 7.60	TUBULAR STEEL Ø (IN) 3.50 (LB / FT) 9.00	TUBULAR STEEL Ø (IN) 4.00 (LB / FT) 10.80	TUBULAR STEEL Ø (IN) 5.00 (LB / FT) 14.60	SIGN FRAME REQUIRED	REMARKS	SIGN DETAIL LOCATION SHSM	SIGN DETAIL LOCATION SIGN DETAILS SHEET #	SIGN DETAIL LOCATION STANDARD SHEET #
NB WALLINGFORD VT RTE 103							FY-FLUORESCENT YELLOW FYG-FLUORESCENT YELLOW GREEN																			"SHSM"-STANDARD HIGHWAY SIGNS AND MARKINGS BOOK			
NB	1.123	A	VD-701	6	10		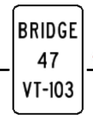 9/14/17	0.42								1	7'-3" X									INSTALL ACROSS FROM EXISTING SIGN SOUTHBOUND			T-42
NB	1.332	A	W1-2L				LEFT CURVE						1		X														
		A	W13-1P				35 M.P.H. PLAQUE						1																	
NB	1.376	A	W1-2L	30	30	FY	9/13/17	6.25								1		14'-9" X								INSTALL ±230' NORTH OF EXISTING SIGN AT MP 1.332 NB	X		
		A	W13-1P	18	18	FY		2.25																			X		
NB	1.406	A	W1-6				9/11/17						1	X																
		A	W1-6	48	24	FY		8.00																		INSTALL ON RETAINED POSTS	X		
NB	1.408	B	W1-6				9/11/17						1		X															
		B	W1-6	48	24	FY		8.00								2		12'-3" 12'-0" X								INSTALL ±10' NORTH OF EXISTING SIGN AT MP 1.406 NB	X		
NB	1.434	B	W1-6	48	24	FY	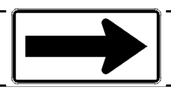 9/11/17	8.00								2		12'-0" 11'-9" X								INSTALL ±50' SOUTH OF EXISTING SIGN AT MP 1.443 NB	X		
NB	1.441	A	W1-6				9/11/17						1		X															
		A	W1-6	48	24	FY		8.00								2		12'-3" 12'-0" X									X		
NB	1.443	B	W1-6				LARGE ARROW BOARD RIGHT						1		X															
NB	1.556	A	VW-092				9/11/17						1	X																
		A	VW-092	30	30			6.25																		INSTALL ON RETAINED POST			T-81
SIGN SUMMARY SHEET							SHEET TOTALS	47.17	0.00	0	0	0	7	0	0	8		115.0		0	0.0	0.0	0.0	0.0					
								SF	SF	EA	EA	EA	EA	EA	EA	EA		FT		EA	LB	LB	LB	LB					
VERMONT AGENCY OF TRANSPORTATION							TOWN DIRECTIONAL TOTALS	173.8	0.0	14	1	1	33	0	0	23		335.0		0	0.0								

PROJECT NAME: **STATEWIDE-SOUTH REGION**
PROJECT NUMBER: **STPG SIGN(57)**
FILE NAME: **z16t041Wallingford103 NB.xls** PLOT DATE: **2/27/2017**
PROJECT MANAGER: **D. MUNRO** DRAWN BY: **W. GORDON**
DESIGNED BY: **P. MCKECHNIE** CHECKED **BRZEZOWSK**
WALLINGFORD VT-103 NB 4 SHEET **113** OF **264**