DIRECTION	MILEPOINT	LOCATION CODE (SHEET 4)	SIGN CODE	WIDTH (IN)	HEIGHT (IN)	SHEETING REMARKS	SIGN LEGEND	NEW SIGNS "A"	NEW SIGNS "B"	EXISTING SIGNS RETAIN	EXISTING SIGNS SALVAGE FROM	EXISTING SIGNS SALVAGE TO	EXISTING SIGNS REMOVE	EXIST POST RETAIN	EXIST POST REMOVE	NUMBER OF NEW POSTS	SQUARE STEEL (IN) 1.75 (LB / FT) 1.88	SQUARE STEEL (IN) 2.00 (LB / FT) 2.42	SQUARE STEEL (IN) 2.50 (LB / FT) 3.35	TUBULAR STEEL Ø (IN) FOUNDATION	TUBULAR STEEL Ø (IN) 3.00 (LB / FT) 7.60	TUBULAR STEEL Ø (IN) 3.50 (LB / FT) 9.00	TUBULAR STEEL Ø (IN) 4.00 (LB / FT) 10.80	TUBULAR STEEL Ø (IN) 5.00 (LB / FT) 14.60	SIGN FRAME REQUIRED	REMARKS	SIGN DETAIL LOCATION SHSM	SIGN DETAIL LOCATION SIGN DETAILS SHEET #	SIGN DETAIL LOCATION STANDARD SHEET #
SB WALLINGFORD VT RTE 103							FY-FLUORESCENT YELLOW FYG-FLUORESCENT YELLOW GREEN																			"SHSM"-STANDARD HIGHWAY SIGNS AND MARKINGS BOOK			
		F	VM1-5				VERMONT 140						1																
		F	M6-2R				UP AND TO THE RIGHT ARROW						1																
		F	M3-3	24	12			2.00																	3D	INSTALL ON RETAINED POSTS SOUTH, GREEN ON WHITE	X		
		F	VM1-5	30	24			5.00																					E-136
		F	M6-2L	21 ~~24~~	15		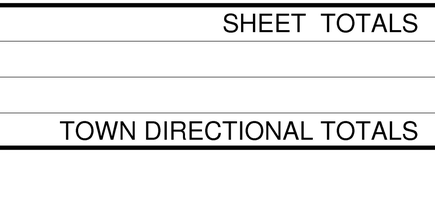 10/27/17 4/9/18	2.19 ~~2.50~~																	ARROW, GREEN ON WHITE	X		
		F	M3-3	24	12			2.00																		SOUTH, GREEN ON WHITE	X		
		F	VM1-5	30	24			5.00																					E-136
		F	M6-2R	21	15			2.19																		ARROW, GREEN ON WHITE	X		
		F	M4-5	24	12			2.00																		TO, GREEN ON WHITE	X		
		F	VM1-5	30	24			5.00																					E-136
		F	M6-2R	21	15			2.19																		ARROW, GREEN ON WHITE	X		
SB	0.205	F	M3-3				SOUTH			1				X															
		F	VM1-5				VERMONT 103			1																			
SB	0.120	F	VD-701				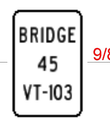 9/8/17						1		X														
		F	VD-701	6	10			0.42								1	8'-0" X												T-42
SIGN SUMMARY SHEET							SHEET TOTALS	28.29 SF	0.00 SF	2 EA	0 EA	0 EA	3 EA	0 EA	0 EA	1 EA	10.0 FT		0 EA	0.0 LB	0.0 LB	0.0 LB	0.0 LB						
VERMONT AGENCY OF TRANSPORTATION							TOWN DIRECTIONAL TOTALS	163.5	0.0	7	0	0	40	0	0	21	305.0		0	0.0									

PROJECT NAME: **STATEWIDE-SOUTH REGION**
PROJECT NUMBER: **STPG SIGN(57)**
FILE NAME: **z16t041Wallingford103 SB.xls** PLOT DATE: **2/27/2017**
PROJECT MANAGER: **D. MUNRO** DRAWN BY: **W. GORDON**
DESIGNED BY: **P. MCKECHNIE** CHECKED **BRZEZOWSK**
WALLINGFORD VT-103 SB 6 SHEET **121** OF **264**